


T.8S.R.14E.W.M.

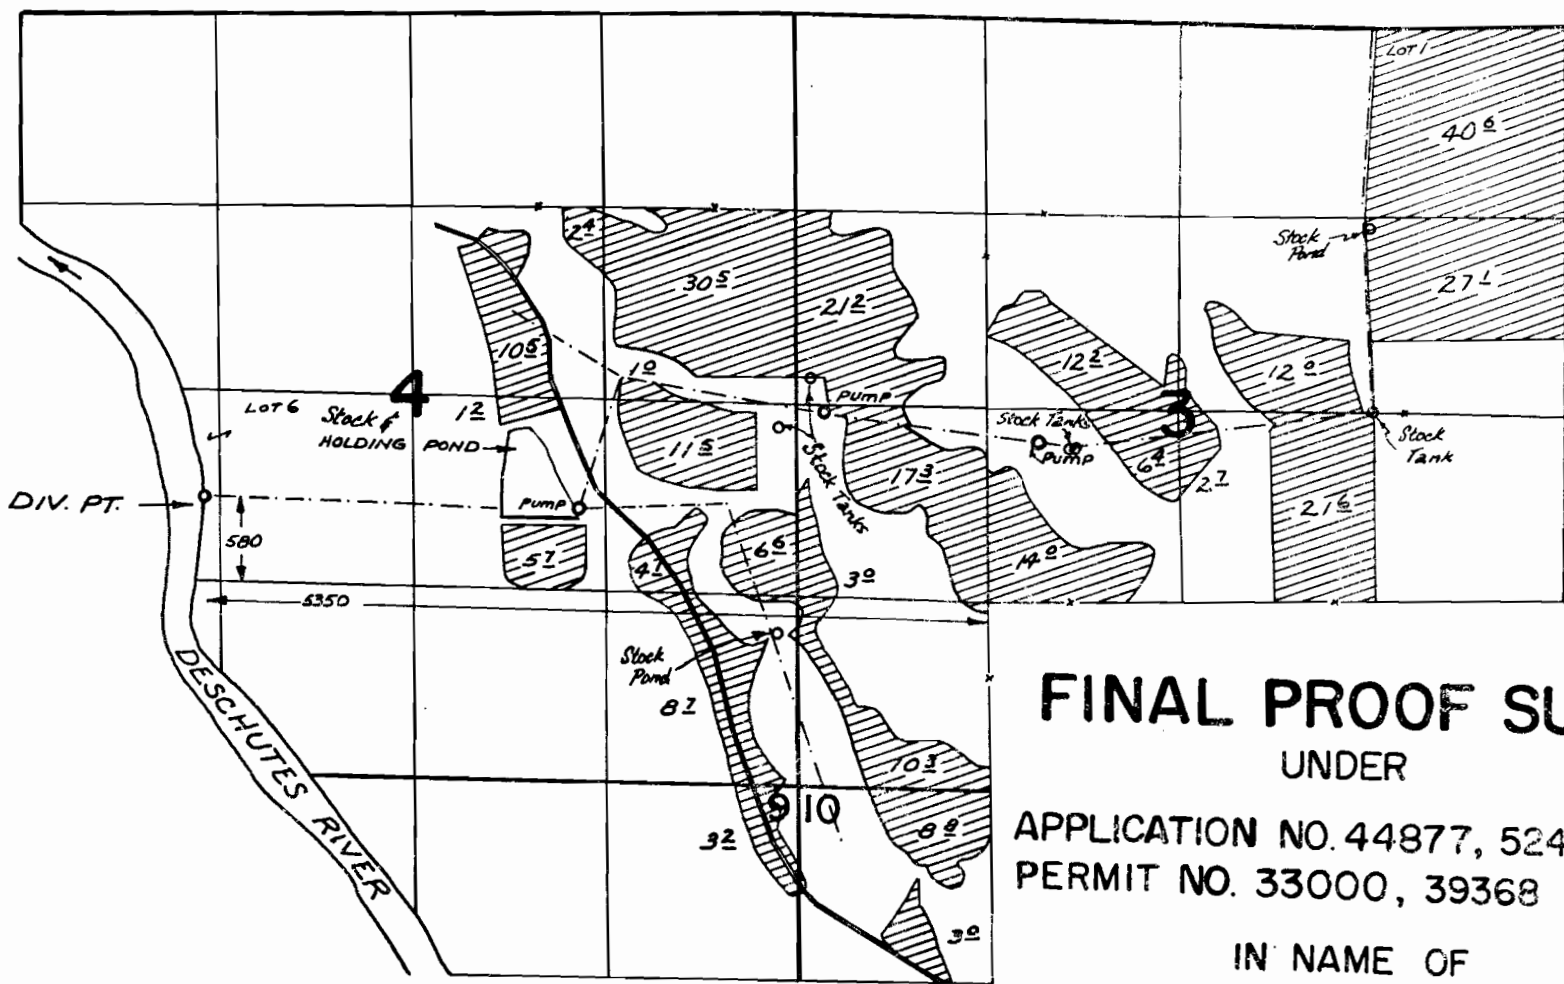

FINAL PROOF SURVEY UNDER

APPLICATION NO. 44877, 52466
 PERMIT NO. 33000, 39368

IN NAME OF
 KASKELA RANCH INC.

SURVEYED SEPT. 10, 1974 BY D. NORBY
 " Aug. 31, 1977 by R.G. Muckert R.G.M.
 172-148