


T.2S. R.12E. W.M.

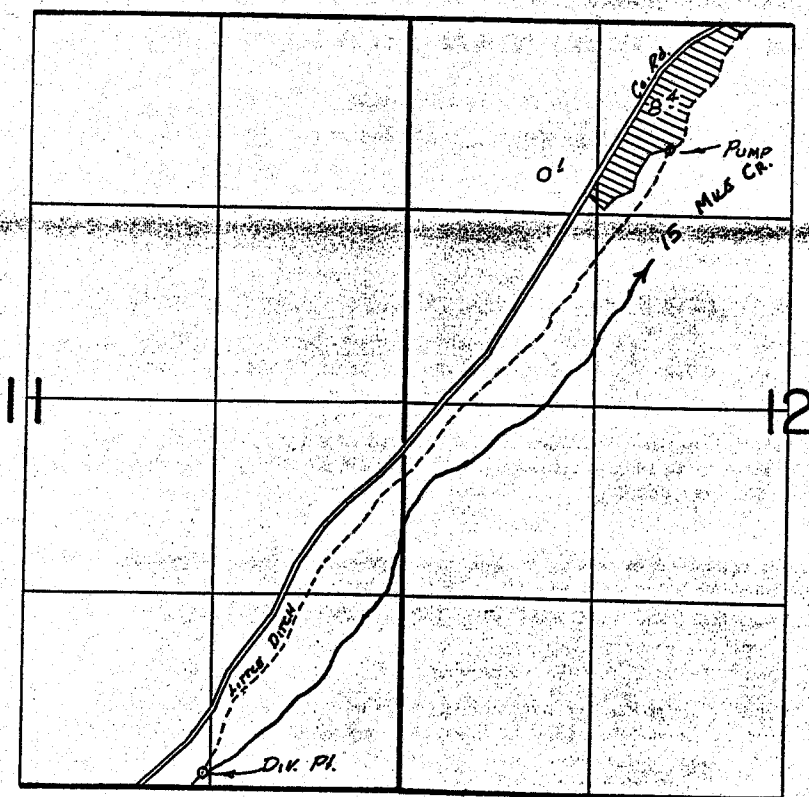

D.K. Pl. Loc.  $100^{\circ} N \pm 1380' W$ . FROM SE COR SEC. 11

**FINAL PROOF SURVEY**  
UNDER

Application No. 47985 Permit No. 35992  
IN NAME OF

WILBUR & CHARLOTTE WEST

Surveyed APRIL 7 1976, by R.G. MUCKEN