


T.2N.,R.14E.,W.M.

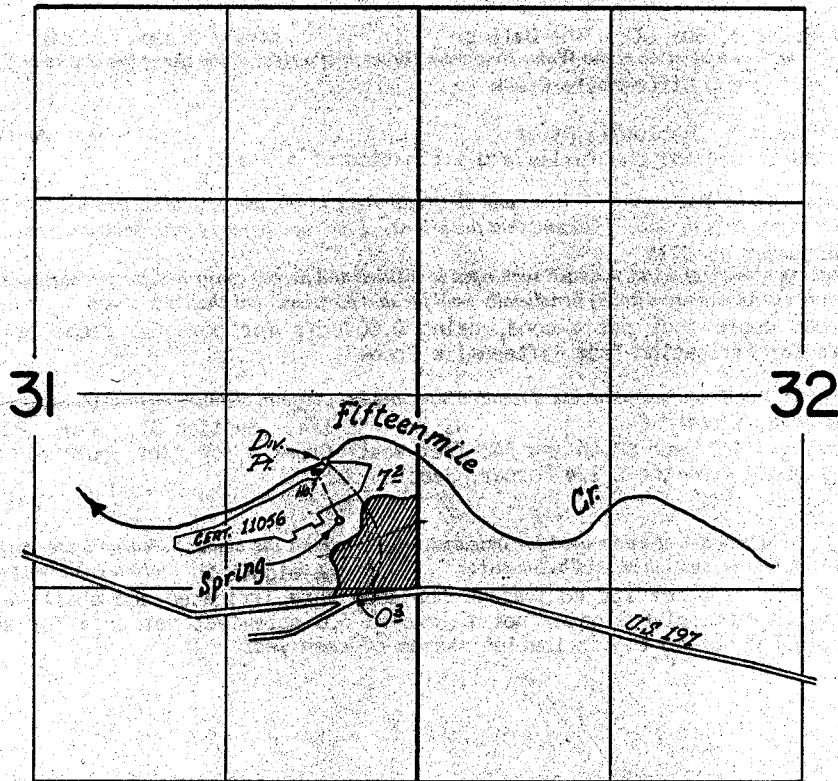

Div. Frs. Loc.: Spring - 860' S. + 540' W.; Creek - 450' S. + 640' W.; Born from S. 1/4 cor. Sec. 31.

FINAL PROOF SURVEY
UNDER

Application No. 53611... Permit No. 40325...
IN NAME OF

JACK A. WATERS

Surveyed June 29, 1977, by R.G. Muckers...