


T. 2 N. R. 4 W. W. M.

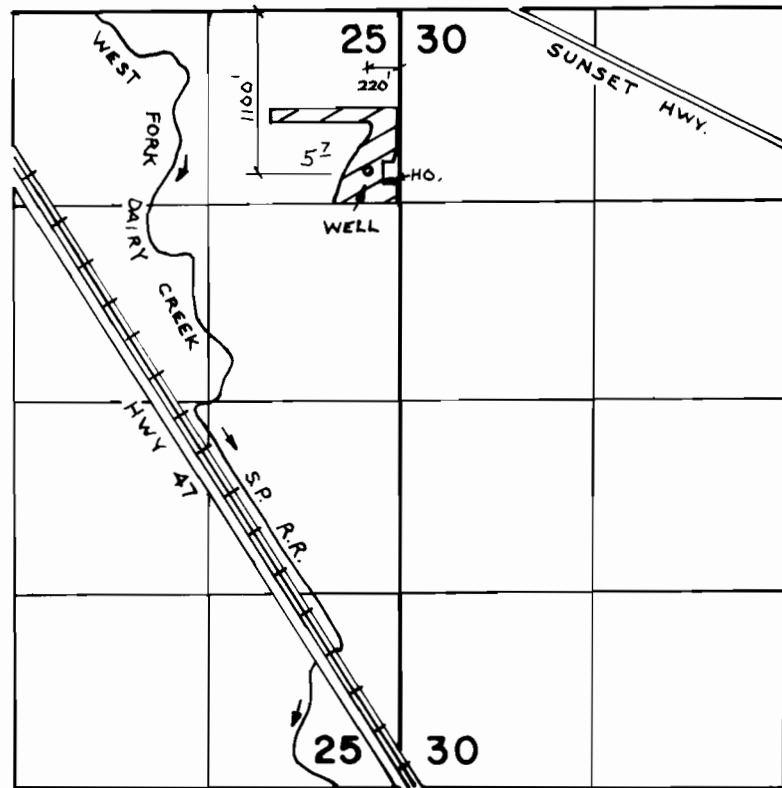

FINAL PROOF SURVEY UNDER

Application No. G-6060 Permit No. G-5724
IN NAME OF
WILLIAM EDGAR DAME

Surveyed May 19 1976, by R.G. Mucken