


T. 2 N. R. 3 W. W. M.

**RECEIVED**  
JAN 30 1995  
WATER RESOURCES DEPT.  
SALEM, OREGON

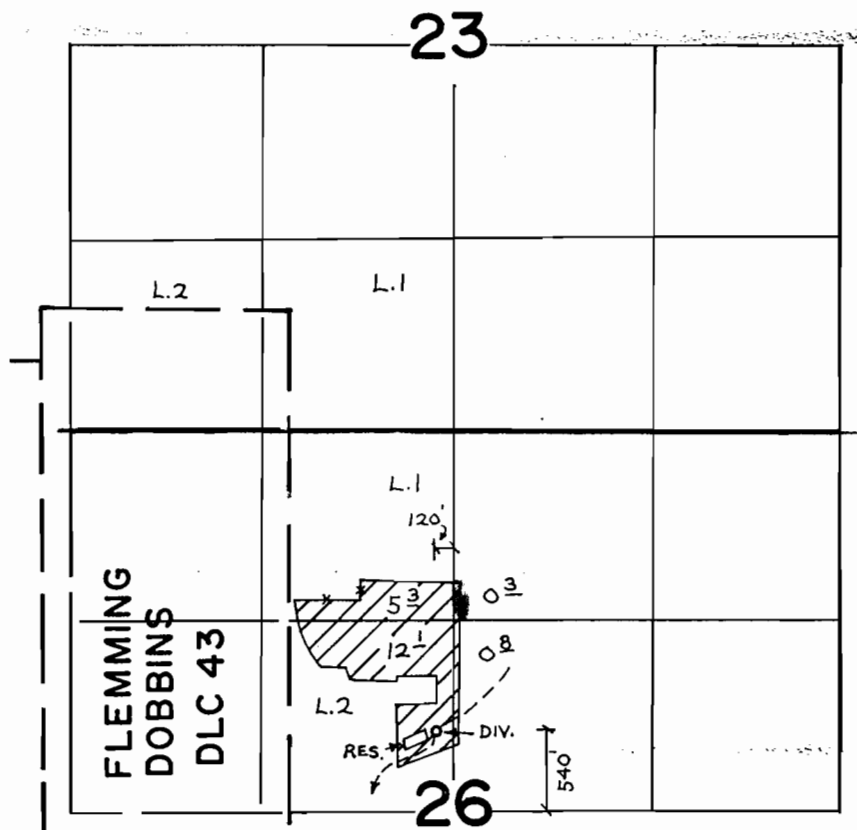

**FINAL PROOF SURVEY**  
UNDER

R-47524                      R-5665  
Application No. 47115      Permit No. 35278  
IN NAME OF  
**PETER KRAUTSCHEID**

Surveyed May 21 1976, by R. G. Mucken