


T.2S.R.3W.W.M.

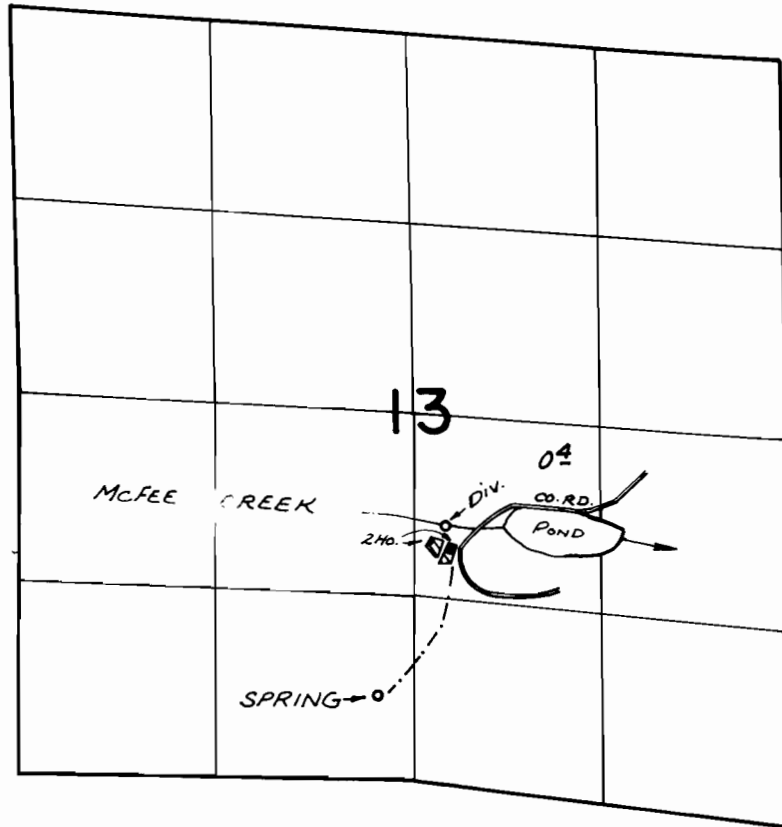

DIV. LOC: 1750' N. & 220' E ; SPRING LOC: 580' N. & 250' W,
BOTH FROM S. 1/4 COR. SEC 13

FINAL PROOF SURVEY
UNDER

Application No. 49632 Permit No. 37228
IN NAME OF

ARCHIE C. & KATHERINE SIMPSON

Surveyed SEPT. 10 1976, by R. MUCKEN