


T. 2N. R. 5W. W.M.

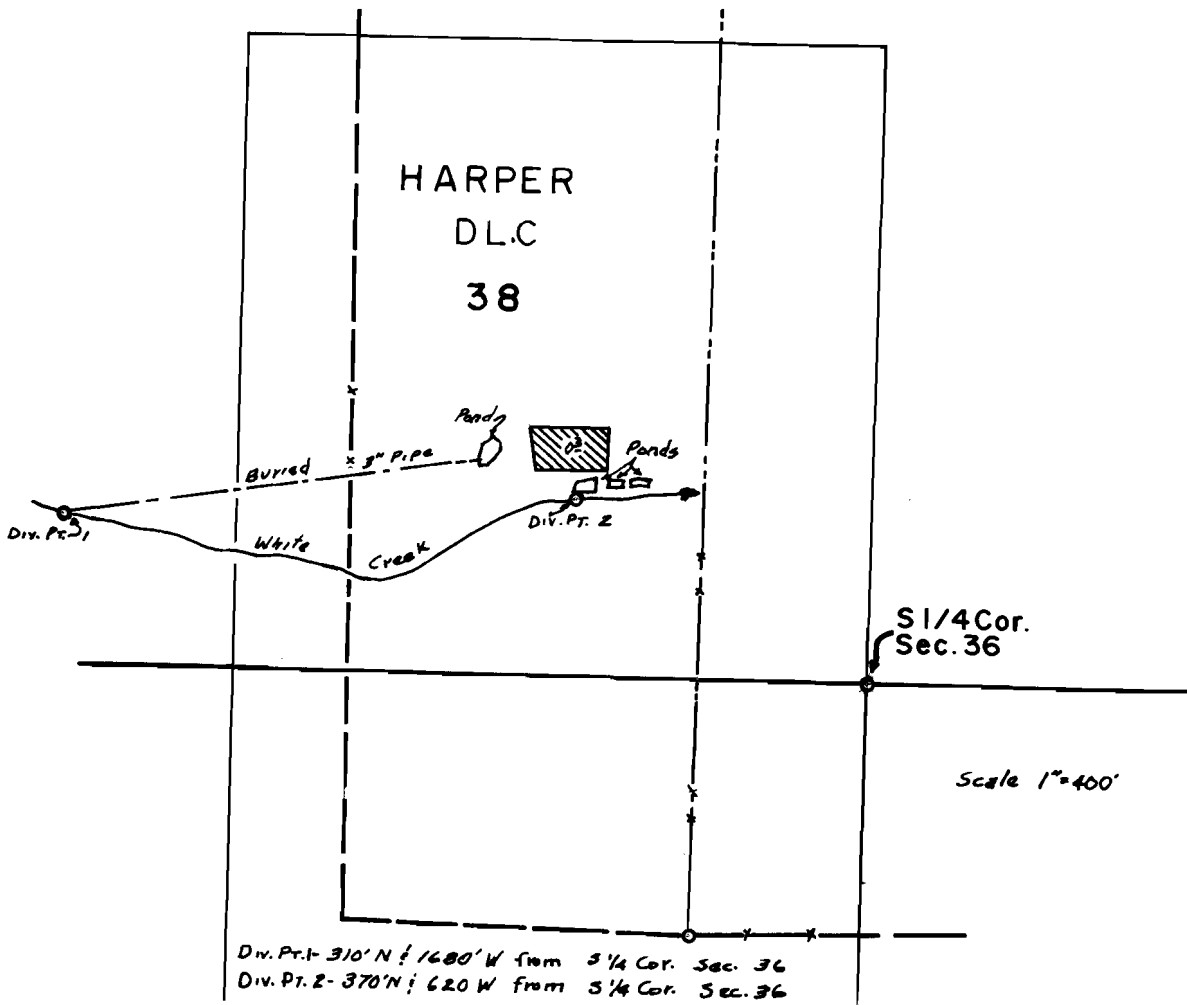

FINAL PROOF SURVEY UNDER

R-54556 R-6523
Application No. 54557 Permit No. 40910
IN NAME OF

BENNIE H. THOMAS

Surveyed OCT. 5, 1977, by S.C. BROWN