


# T. 2N. R. 5W. W.M.

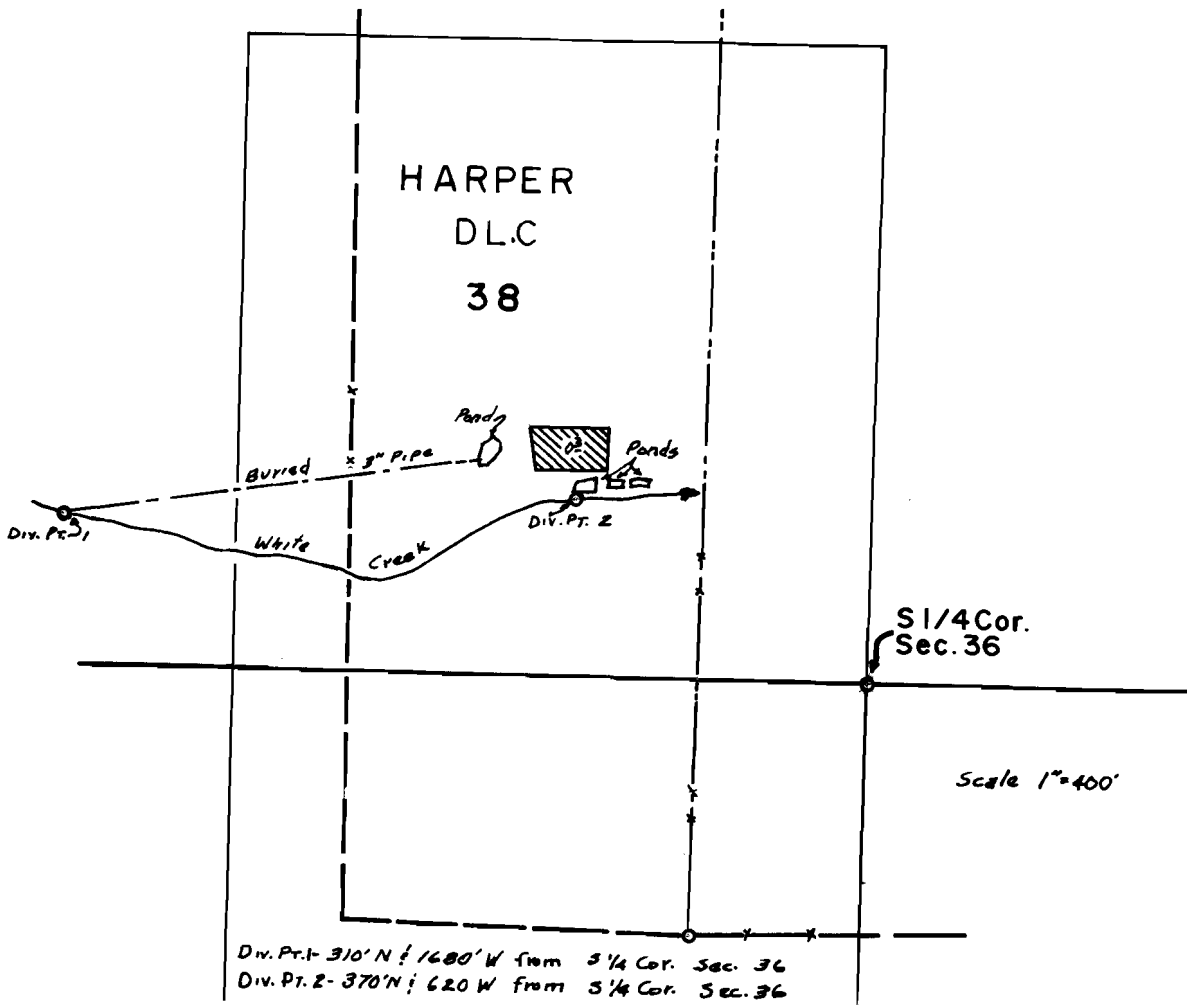

## FINAL PROOF SURVEY UNDER

R-54556                      R-6523  
Application No. 54557 Permit No. 40910  
IN NAME OF

BENNIE H. THOMAS

Surveyed OCT. 5, 1977, by S.C. BROWN