


T.5S.R.3W.W.M.

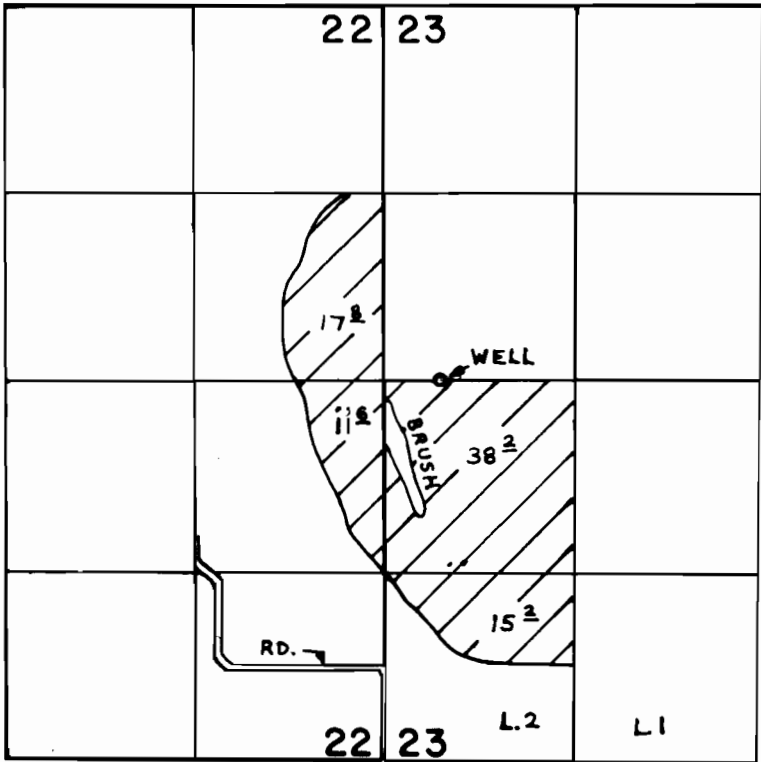

WELL LOC. - 10'S. & 380'E. FROM E. 1/4 COR. SEC. 22

FINAL PROOF SURVEY

UNDER

Application No. **G-5563** Permit No. **G-5433**
IN NAME OF
CLARK NOBLE

Surveyed June 1, 1976, by R.G. Mucken.