


T. 3S. R. 2W. W.M.

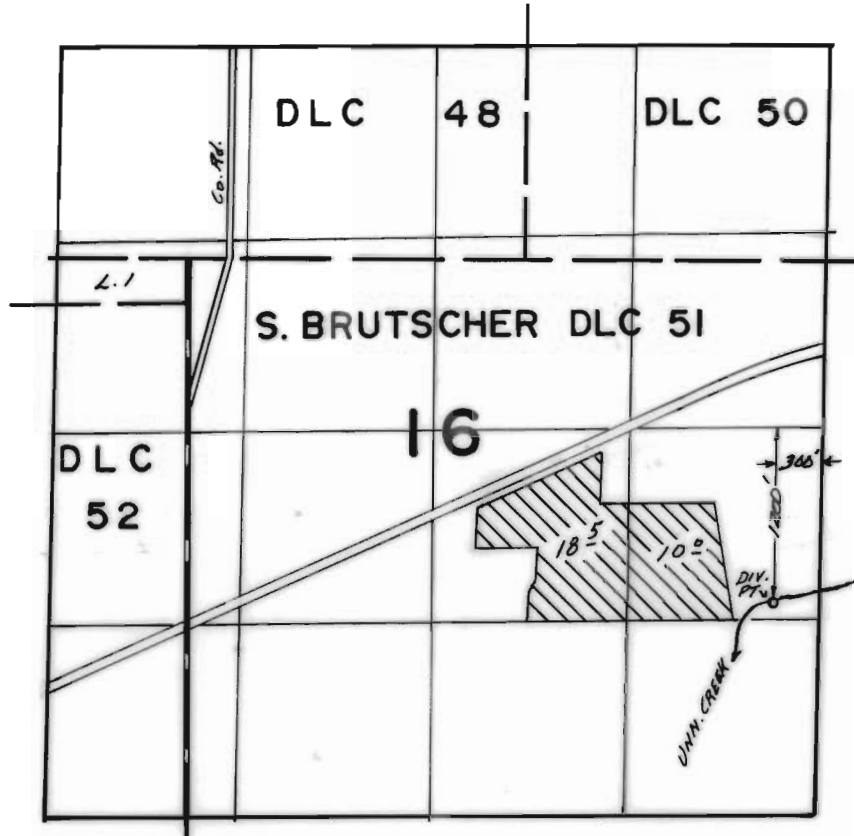

FINAL PROOF SURVEY UNDER

Application No. 50932... Permit No. 38453...
IN NAME OF

HUBERT SLEGGERS

Surveyed April 15, 1976, by L.H.NUNN.....