


T.5 S.R.4 W.W.M.

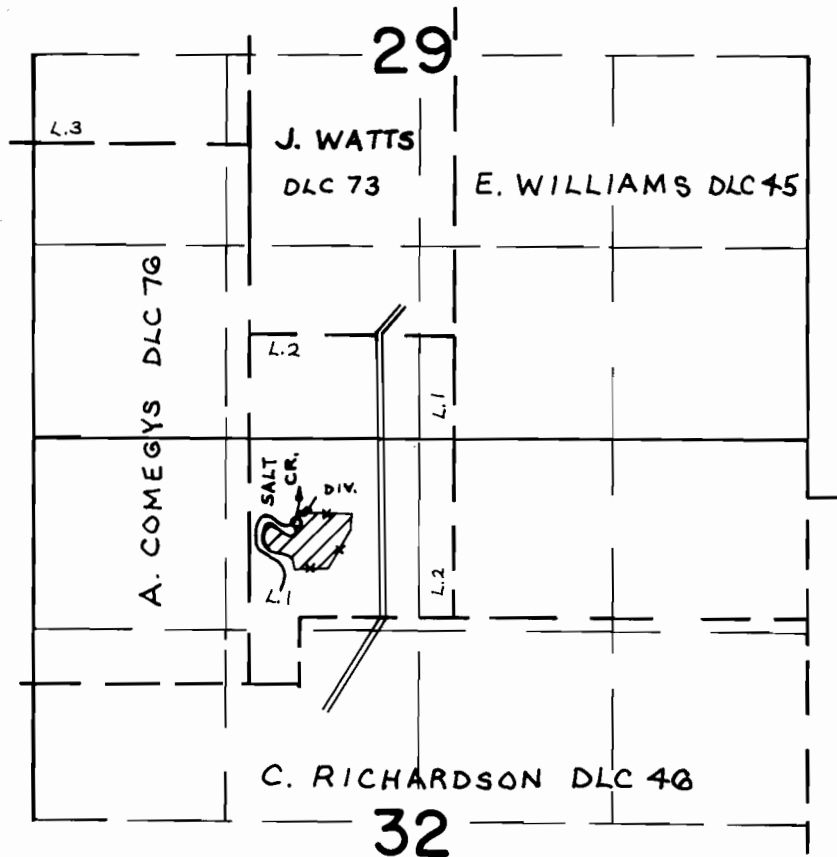

DIV. LOC. - 1300'S. & 330'E. FROM S.W. COR. JOHN WATTS D.L.C. 73

FINAL PROOF SURVEY UNDER

Application No. 51074 Permit No. 38537
IN NAME OF

NORMAN D. MCKEE

Surveyed June 3 1976, by R.G. Mucken.