


T.5S.R.4W.W.M.

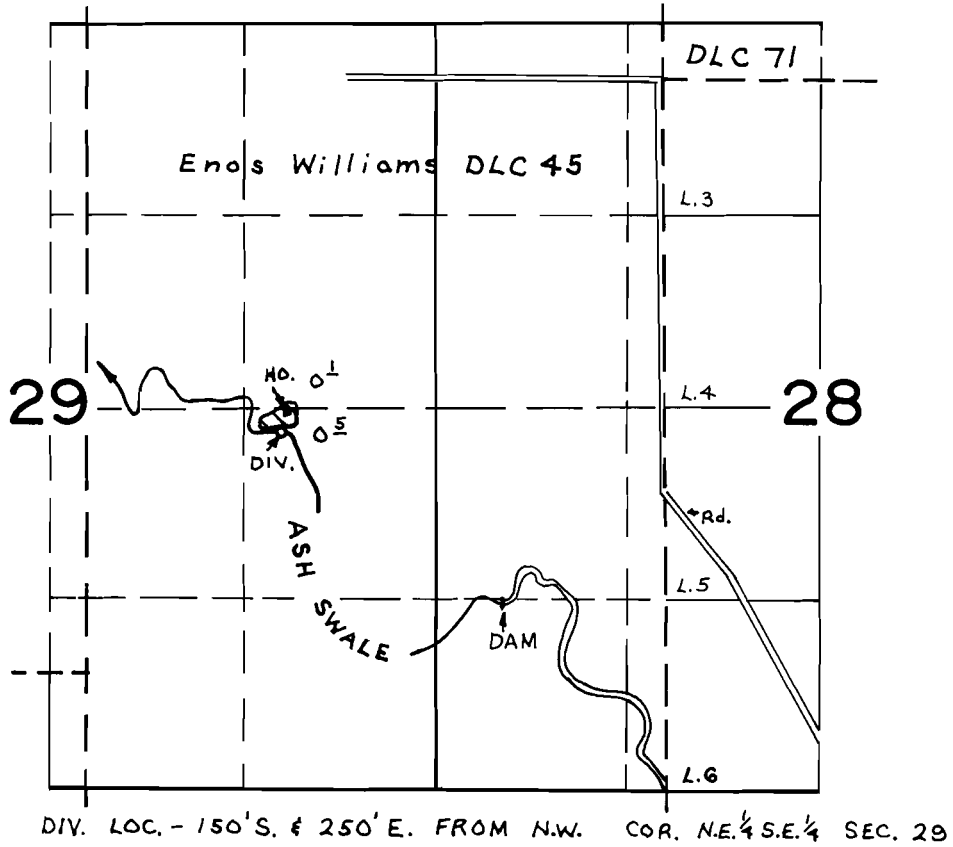

FINAL PROOF SURVEY UNDER

Application No. 53072 Permit No. 38570
IN NAME OF
ELMER CHRISTENSEN

Surveyed June 3 1976, by R.G. Mucken.