


T.3 S.R.2W. W.M.

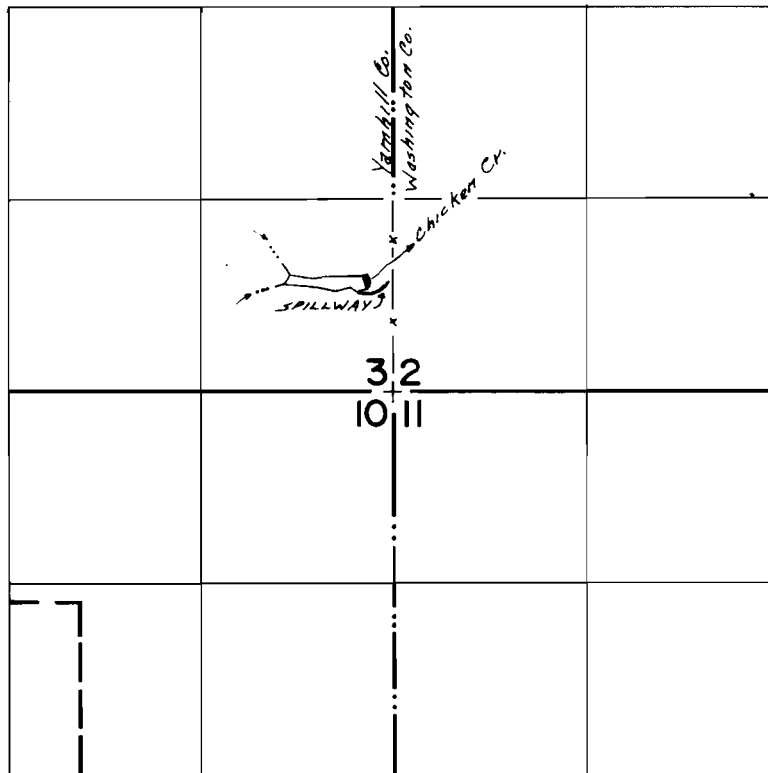

Div. Pt. Loc. 730' N. 163' W. From SE Cor. Sec. 3

FINAL PROOF SURVEY
UNDER

R-54105 R-6443
Application No. 54106... Permit No. 40436...
IN NAME OF

ROBERT PAMPLIN JR.

Surveyed Sept. 8, 1977, by S.C. BROWN