


T.3S.R.4W.W.M.

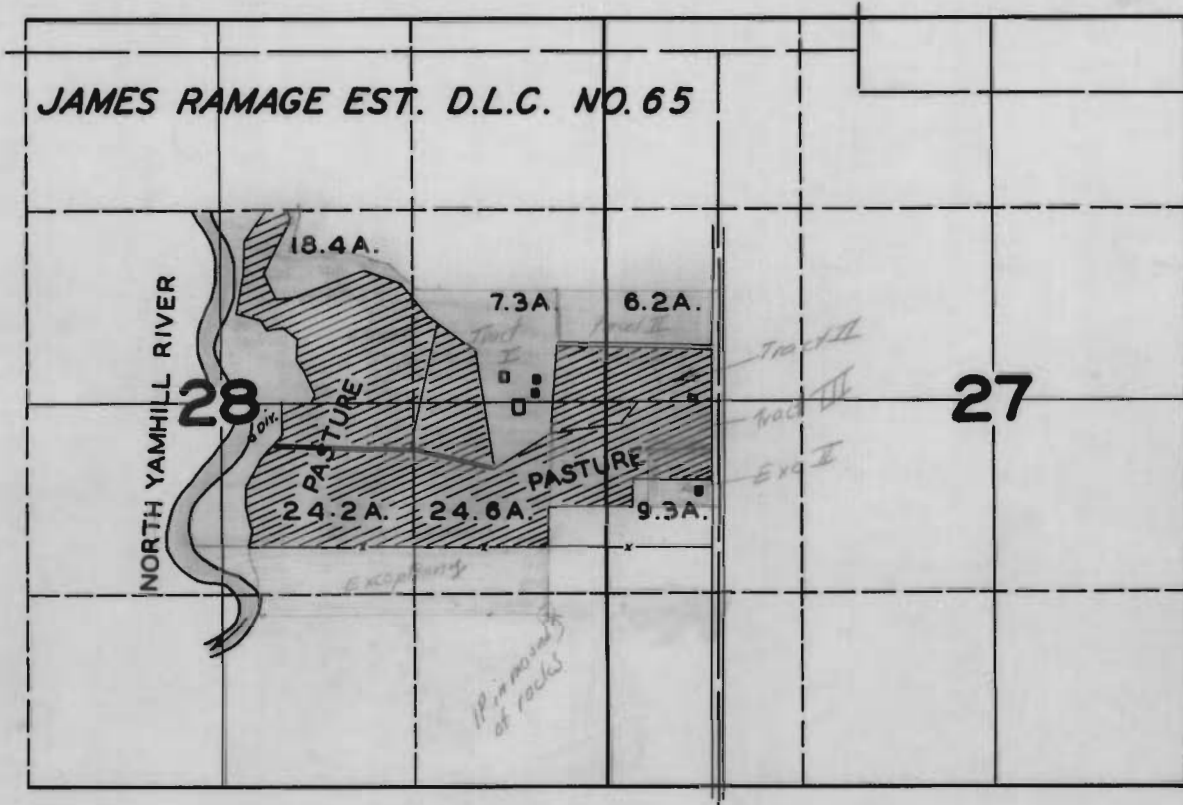

FINAL PROOF SURVEY

UNDER

Gordon.

Application No. **18069** Permit No. **13735**
IN NAME OF

Surveyed **SEP. 20 1947**, by **JAS. E. BUNNELL**