


T. 4 S. R. 4 W. W. M.

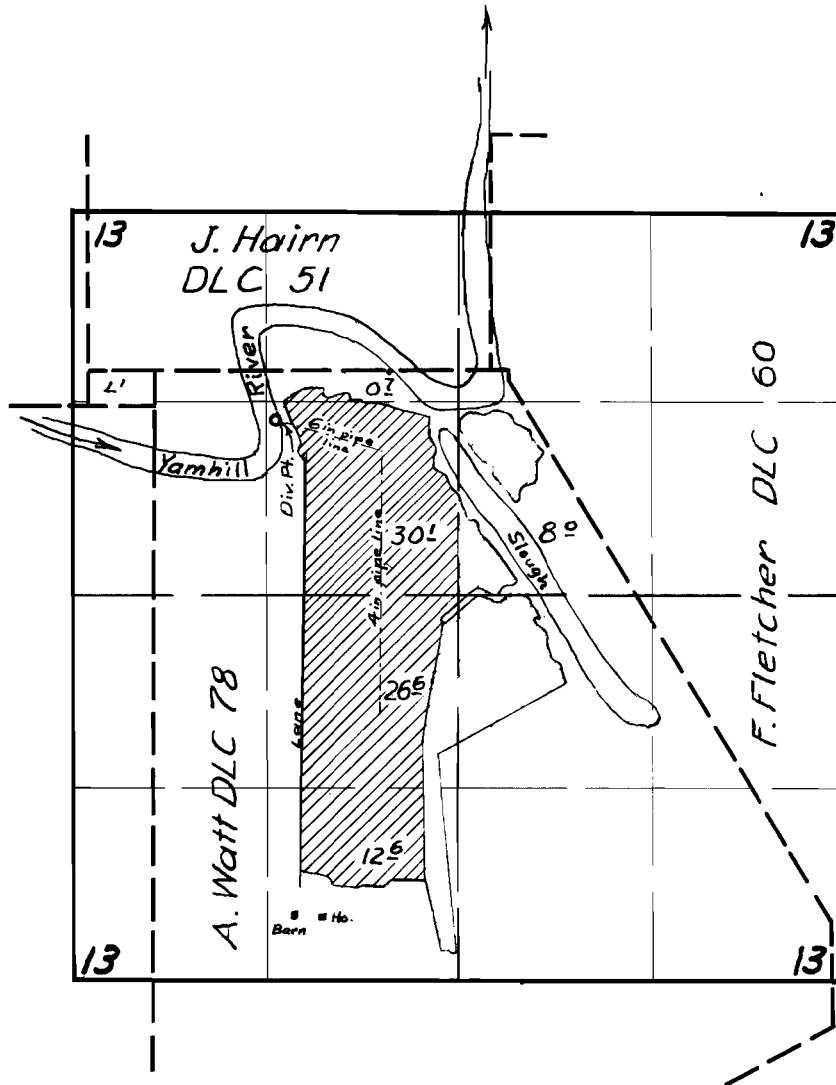

FINAL PROOF SURVEY

UNDER

Application No. 27124 Permit No. 21337

IN NAME OF

Marvin D. Williams

Surveyed 15 Mar 1956, by M. B. Bish