


T.4 S.R.4 W.W.M.

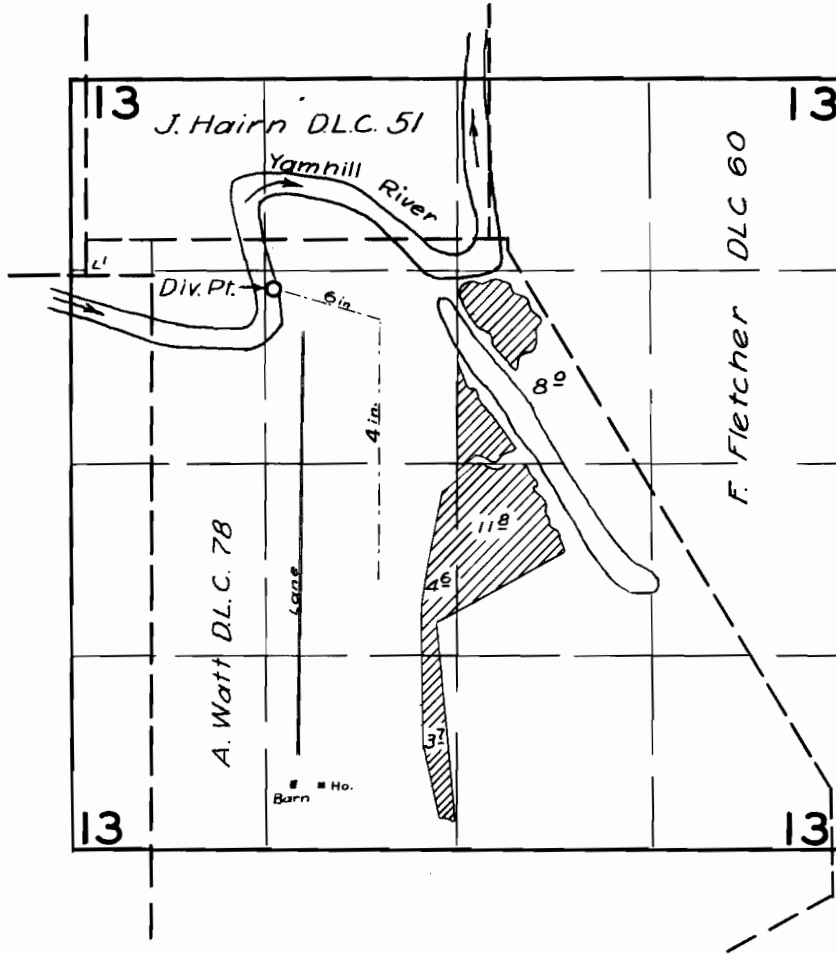

FINAL PROOF SURVEY UNDER

Application No. 31395... Permit No. 24749...
IN NAME OF

Marvin D. Williams

Surveyed *Mar. 15*, 1956, by *Tr. Bish*...