


T. 5S. R. 7W. W.M.

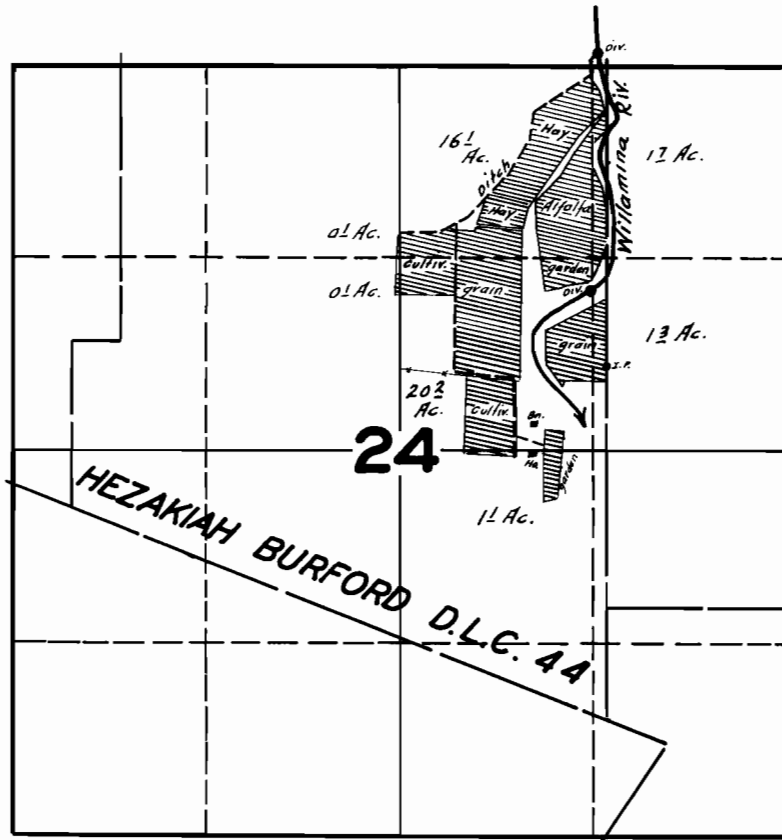

FINAL PROOF SURVEY UNDER

Application No. 14119 Permit No. 10231

IN NAME OF
ROXIE MENDENHALL & GUY FENDALL

Surveyed JUNE 8, 1945, by *[Signature]*