


T. 14 S. R. 5 W. W.M.

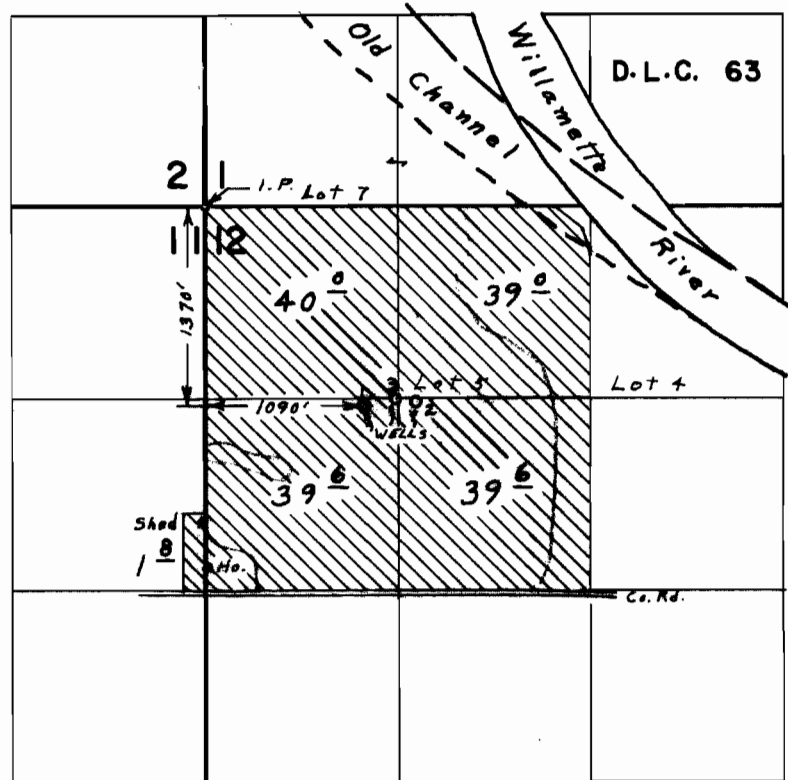

Well No. 2 Loc. 1340'S 1440'E from NW Cor. Sec. 12.

FINAL PROOF SURVEY
UNDER

G-6240 G-5885
G-4942 G-4664
Application No. G-3498 Permit No. G-3295
IN NAME OF

CROCKER BROTHERS (HERRON PLACE)

Surveyed March 30, 1970, by L. E. Gould