


T. 12 S., R. 6 W. W.M.

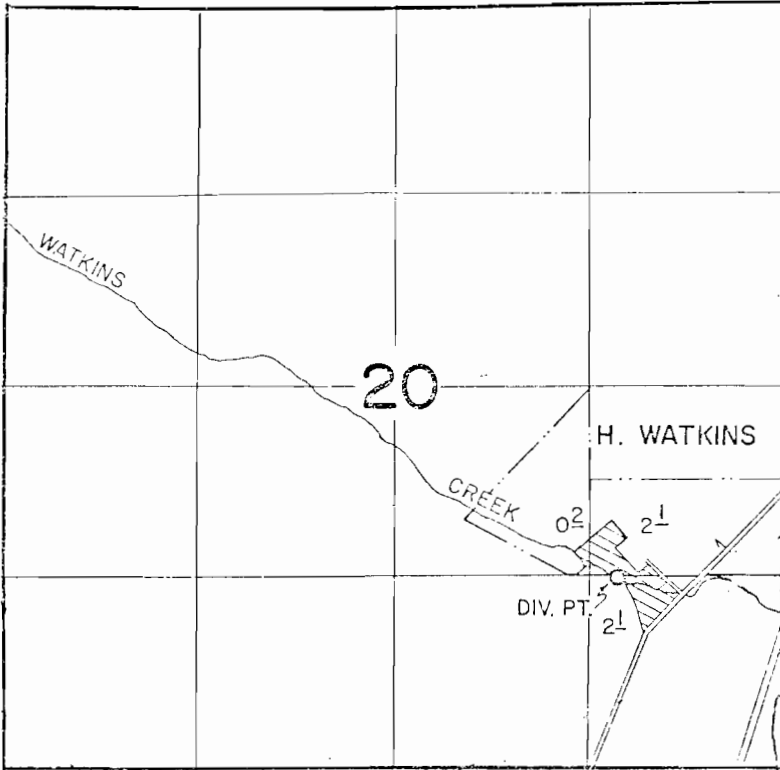

DIV. PT. LOC: 1300 FT. N., & 1130 FT. W., FROM SE COR. SEC. 20

FINAL PROOF SURVEY
UNDER

Application No. 46532. Permit No. 34764.
IN NAME OF

..... HUGH O. WATKINS

Surveyed Apr. 21, 1976, by C.R. King