


# T.11S.R.6W.W.M.

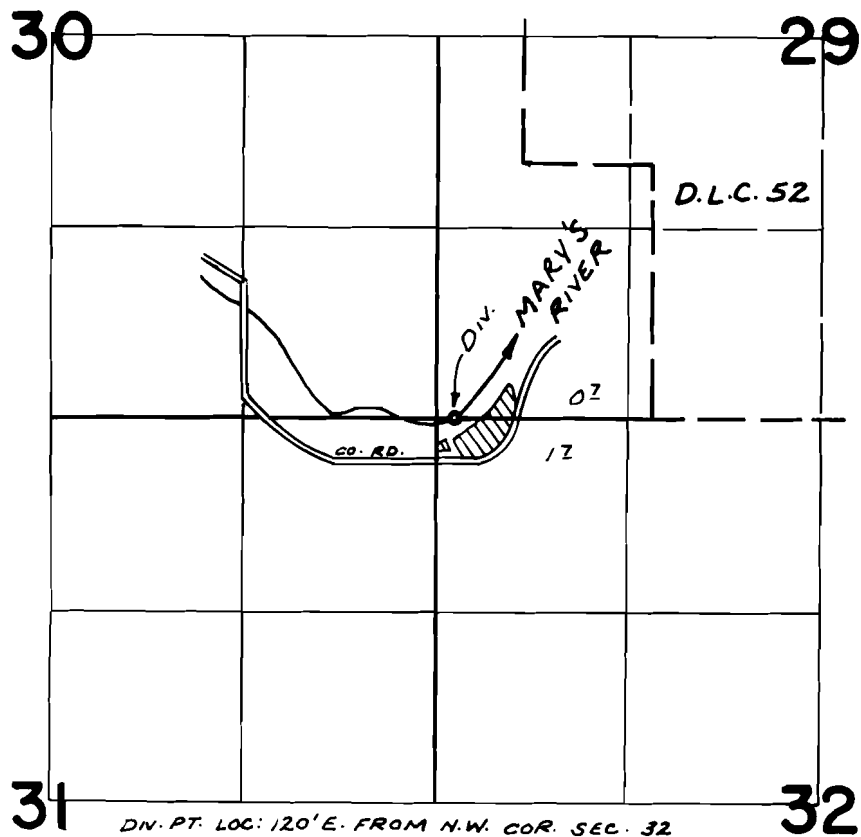

## FINAL PROOF SURVEY UNDER

Application No. ~~54445~~ Permit No. 40846  
IN NAME OF

*TOM D. & ROSIE LEE STEPHENSON*

Surveyed AUG. 17, 1977, by Bob BARWIN