


T.5 S. R.1 W. & 1 E. W.M.

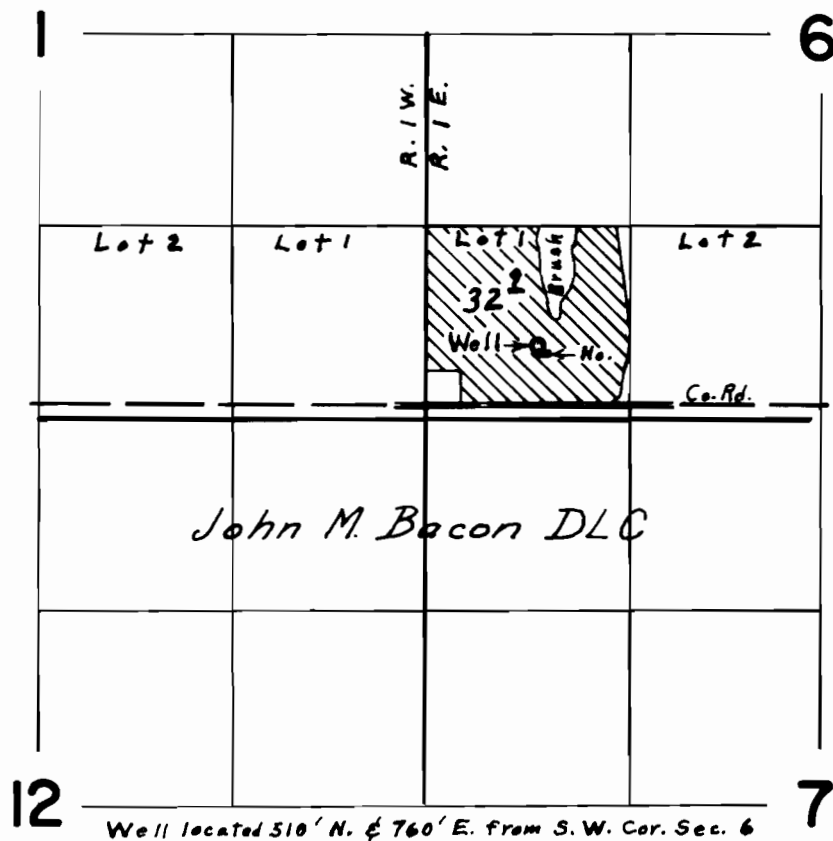

FINAL PROOF SURVEY
UNDER

Application No. G-6226 Permit No. G-5683
IN NAME OF

RICHARD & ELISE J. HAVENS

Surveyed March 31, 1976, by L. E. Gould