


T. 4 S., R. 1 E., W. 1 M.

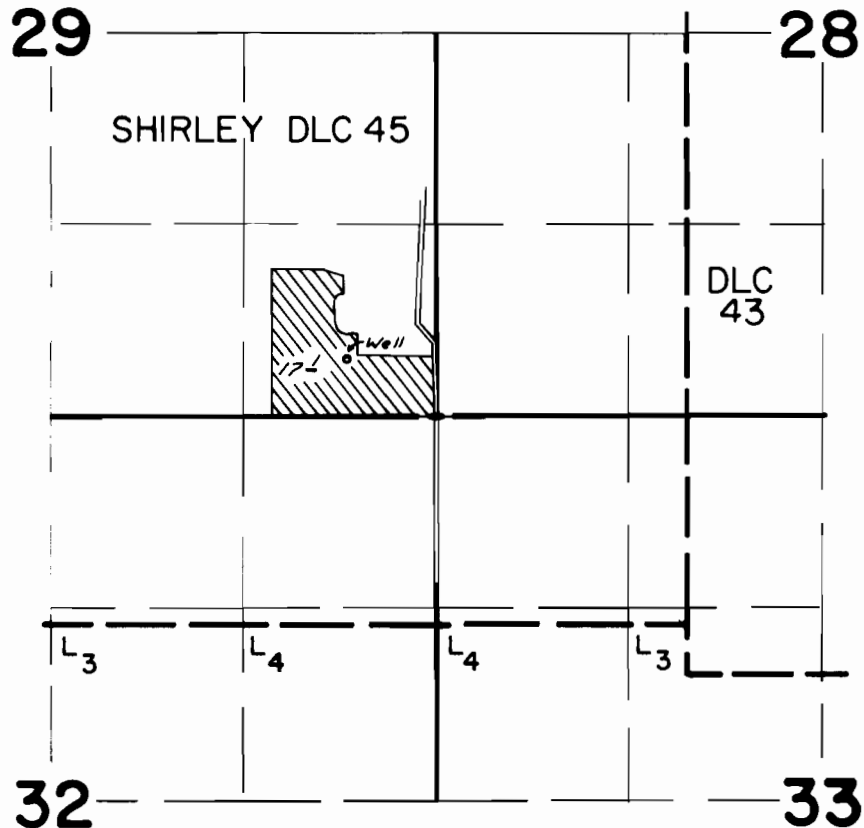

Well Loc.: 400' N. & 600' W. from SE Cor Sec 29

FINAL PROOF SURVEY UNDER

Application No. G-6251 Permit No. G-5893
IN NAME OF

Homer Knopp

Surveyed July 28, 1977, by dc Brown