


T.4S.,R.1E.,W.M.

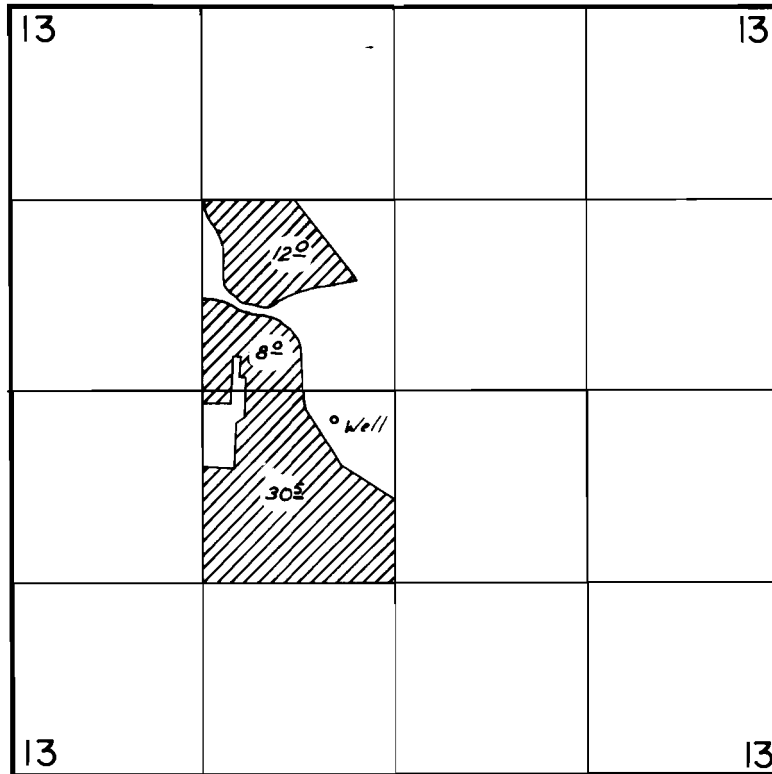

Well Loc.: 190' S. & 440' W. from ctr. of Sec 13

FINAL PROOF SURVEY UNDER

Application No. G-6497 Permit No. G-6114
IN NAME OF

Edward B. Butcher

Surveyed July 27, 1977, by AC Brown