


T.3S., R.1W., W.M.

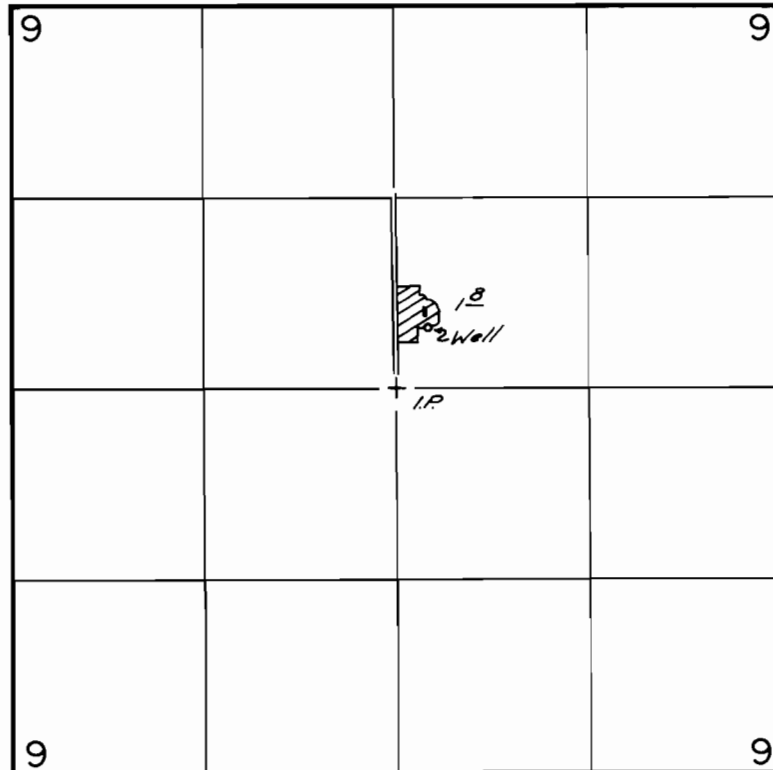

Well Loc.: 420 'N. & 220 'E. from ctr. $\frac{1}{4}$ cor., Sec. 9

FINAL PROOF SURVEY
UNDER

Application No. G-7159 Permit No. G-6605
IN NAME OF

Richard H. Caffall

Surveyed Aug 2, 1977, by Al Brown

DFK-2LL-13