


T.4S.,R.1E.,W.M.

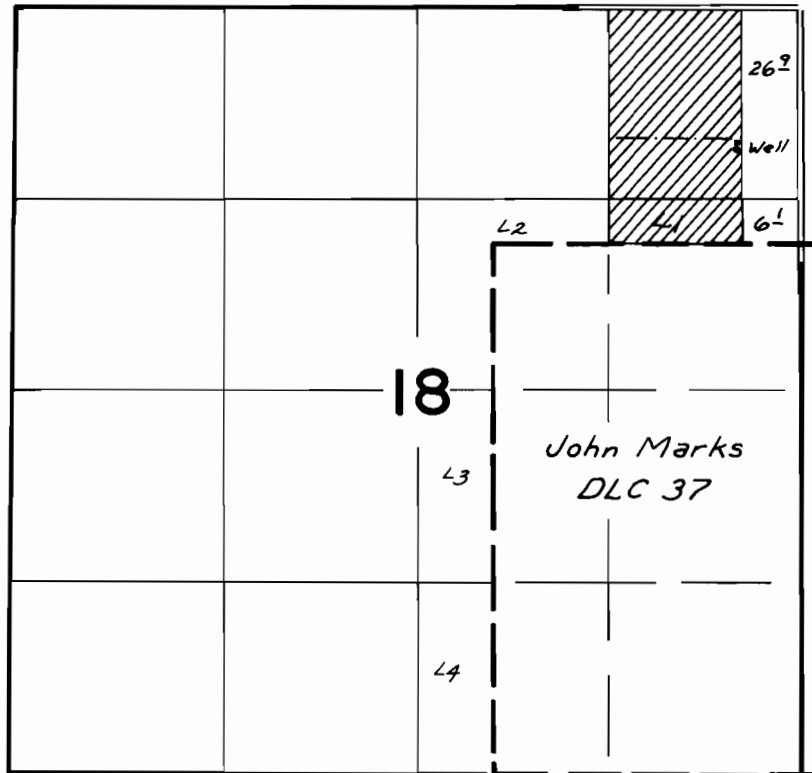

Well Loc.: 970' S. & 440' W. from NE Cor. Sec. 18

FINAL PROOF SURVEY UNDER

Application No. G-7345 Permit No. G-6776
IN NAME OF

Wayne Yoder

Surveyed July 27, 1977, by J.C. Brown