


# T.5S.,R.3E.,W.M.

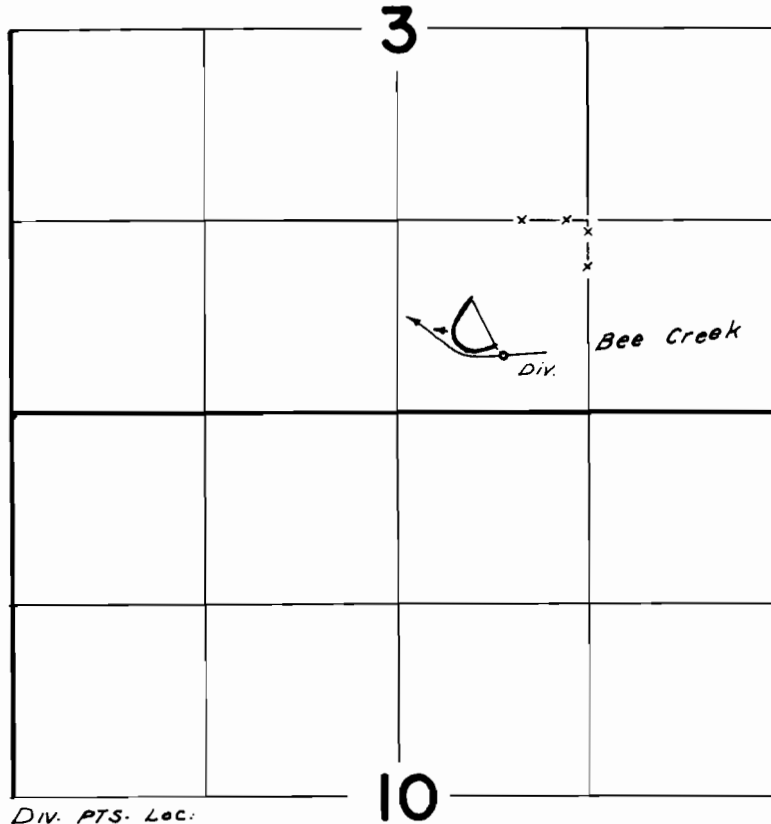

Div. PTS. Loc:  
BEE CR + 390 ft. N. & 730 ft. E. from S 1/4 cor., Sec. 3  
RES. - 550 ft. N & 370 ft. E from S 1/4 cor., Sec. 3

## FINAL PROOF SURVEY UNDER

R-51050                      R-6033  
Application No. 51051    Permit No. 37143  
IN NAME OF

Marion R. Olsen

Surveyed July 28, 1977, by AC Brown