


T. 5 S., R. 3 E., W.M.

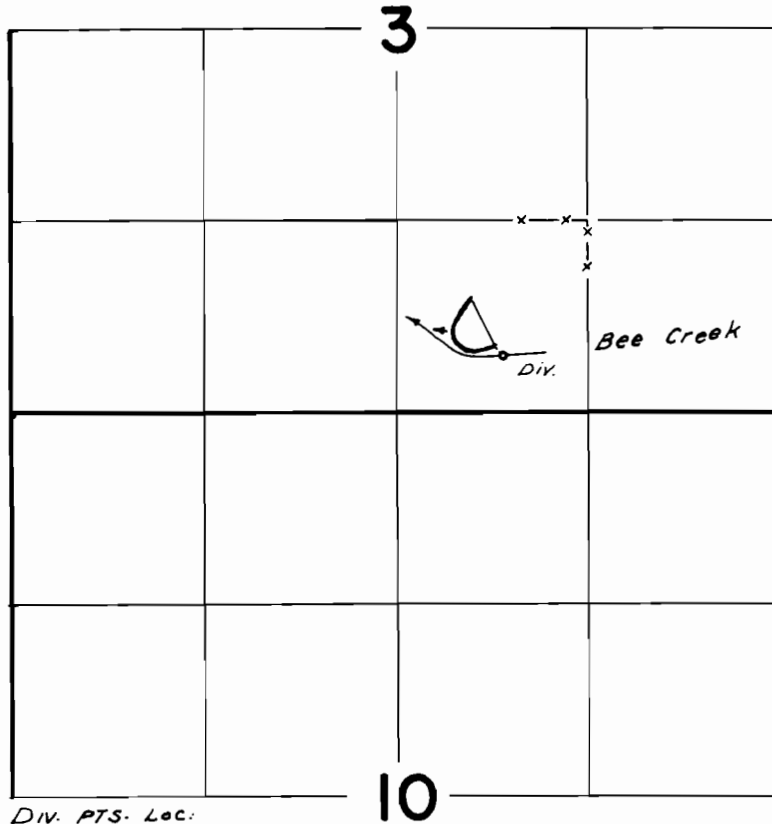

Div. PTS. Loc:

BEE CR = 390 ft. N. & 730 ft. E. from S 1/4 cor., Sec. 3
RES. - 550 ft. N & 370 ft. E from S 1/4 cor., Sec. 3

FINAL PROOF SURVEY UNDER

Application No. R-51050 Permit No. R-6033
IN NAME OF

Marion R. Olsen

Surveyed July 28, 1977, by AC Brown