


T.2S.R.4E.W.M.

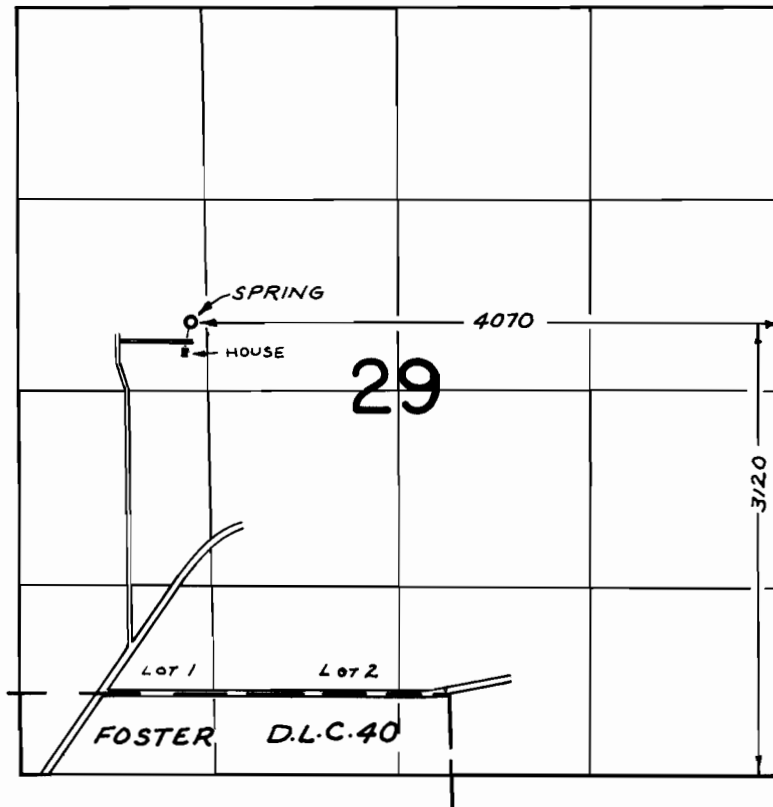

FINAL PROOF SURVEY
UNDER

Application No. 52332 Permit No. 37931
IN NAME OF

DON A. COX

Surveyed AUG. 15 1977, by R. MUCKEN