


T. 5 S., R. 1 E., W. 1 M.

SECTION 16

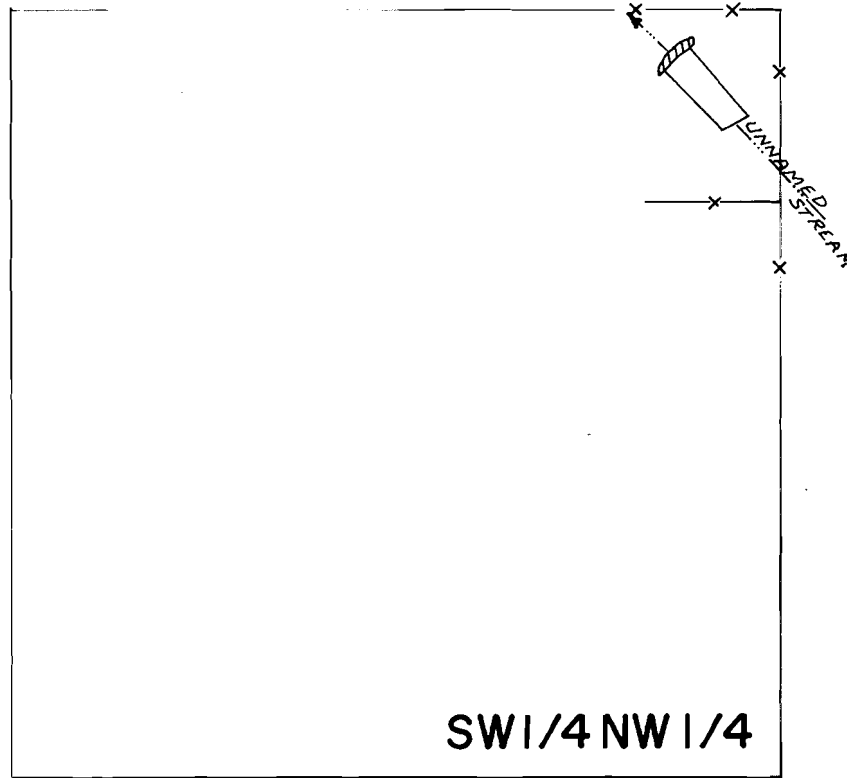

SCALE 1" = 330'

FINAL PROOF SURVEY
UNDER

Application No. R-52738 Permit No. R-6364
IN NAME OF

Carroll L. & Velma L. Hibbard

Surveyed July 22, 1977, by AC Brown

PTS-1977-L