


T. 3 S., R. 2 E., W. M.

SECTION 26

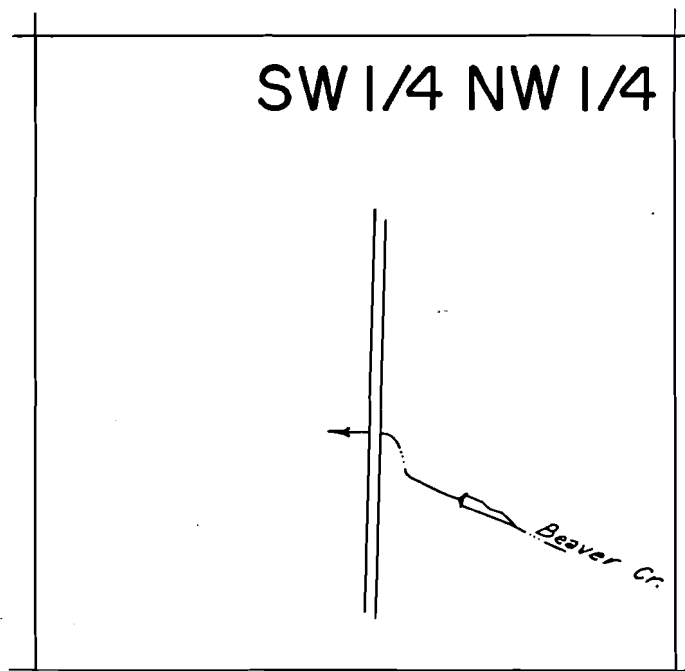

Dam Loc.: 350' N., & 1760' W., from Center
Section 26

SCALE 1" = 400'

FINAL PROOF SURVEY
UNDER

R-53338 R-6334
Application No. 53339 Permit No. 39574
IN NAME OF

John B. Haggemiller

Surveyed Aug 3, 1977, by dCBrown

PTS-1977-L