


T.5S.,R.1E.,W.M.

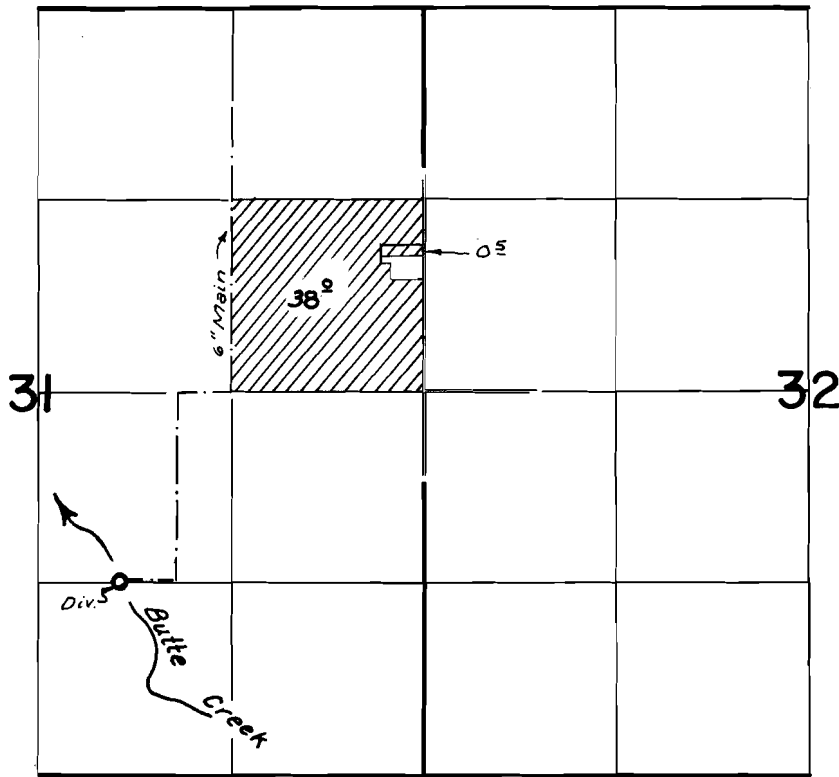

Div. Pt. Loc.: 1315 'S., & 2080 'W., from E $\frac{1}{4}$ cor. Sec. 31

FINAL PROOF SURVEY UNDER

Application No. 53403 Permit No. 39745

IN NAME OF

James W. Madsen

Surveyed July 22, 1977, by dc Brown