


T.2S.R.1E.W.M.

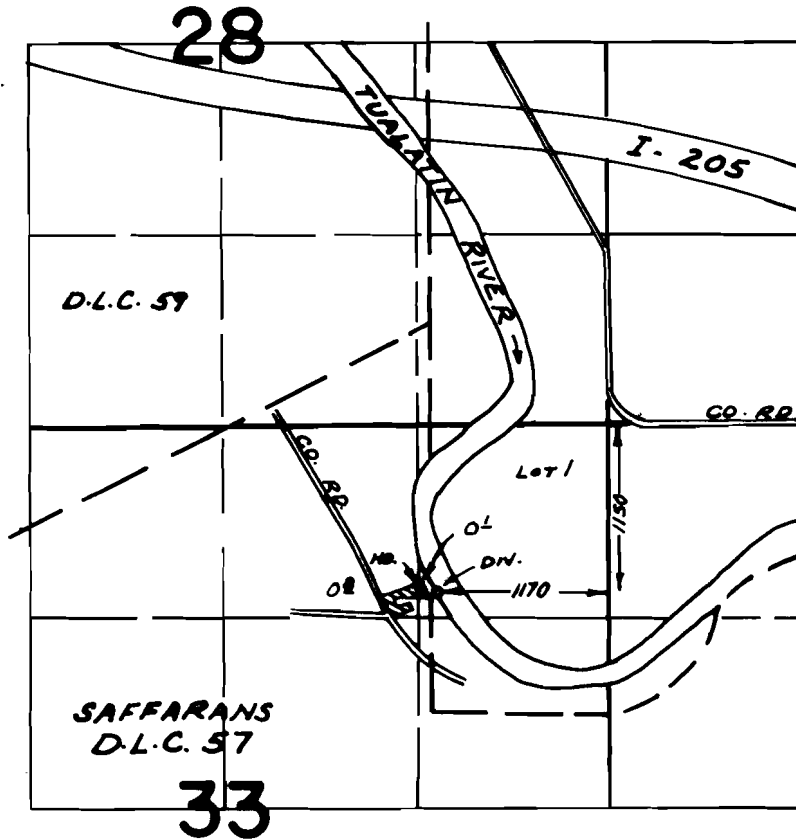

FINAL PROOF SURVEY UNDER

Application No. 53518 Permit No. 40059
IN NAME OF

DON R. & GAIL E. LARSEN

Surveyed JULY 6, 1977, by R. MUCKEN