


# T. 3 S., R. 2 E., W. M.

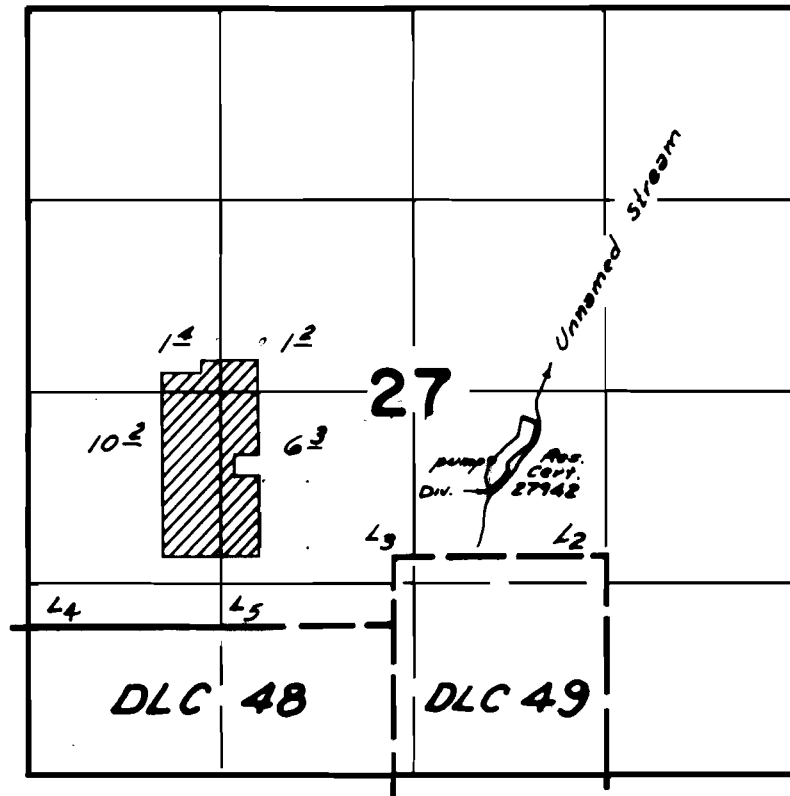

DIV. LOC: 710'S. & 510'E. FROM CENTER SEC. 27

## FINAL PROOF SURVEY UNDER

Application No. 53547 Permit No. 40075

IN NAME OF  
ESTATE OF  
John Rousett

Surveyed Aug 5, 1977 by AC Brown