


T. 5 N., R. 9 W., W.M.

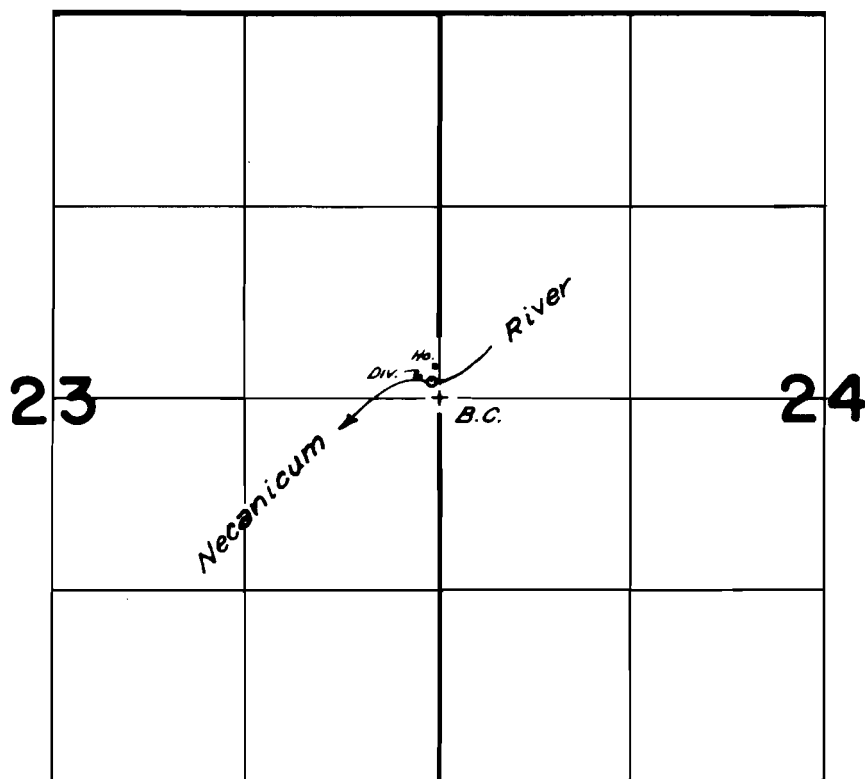

DIV. PL. LOC.: 100' N. & 50' W., from E. $\frac{1}{4}$ Cor. Sec. 23

FINAL PROOF SURVEY
UNDER

Application No. 54339 Permit No. 40579
IN NAME OF

Dean Frederick Bonde

Surveyed Sept 2, 1977, by JC Brown