


T.4N.R.2W.W.M.

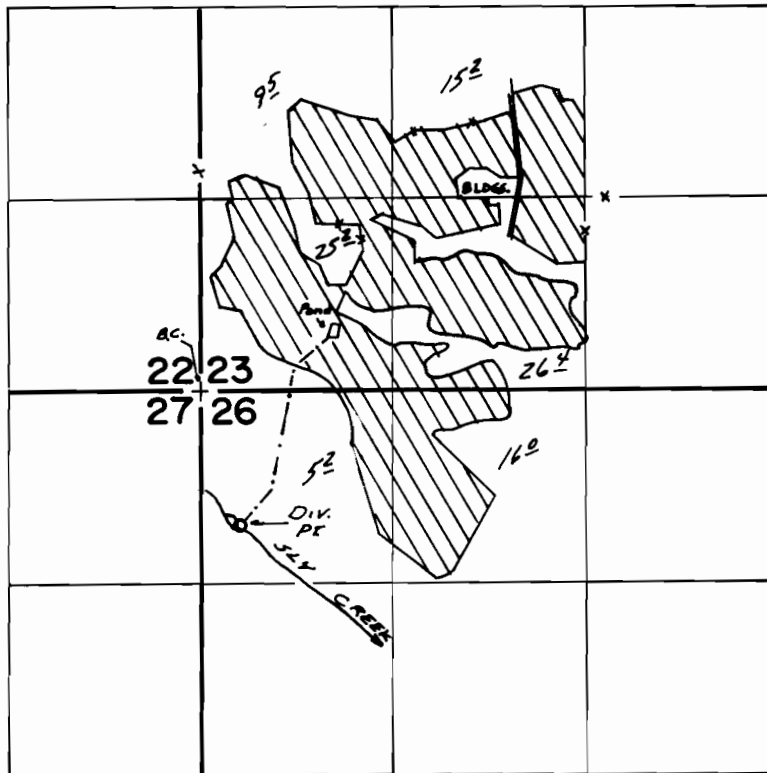

DIV. PT. - 920'S 1/2 260'E FROM NW COR. SEC. 26

FINAL PROOF SURVEY UNDER

Application No. 43139..... Permit No. 31951.....
IN NAME OF

JAMES C. ERNEST

Surveyed Aug. 9..... 1977., by S.C. BROWN.....