


T.5N.R.4W. W.M.

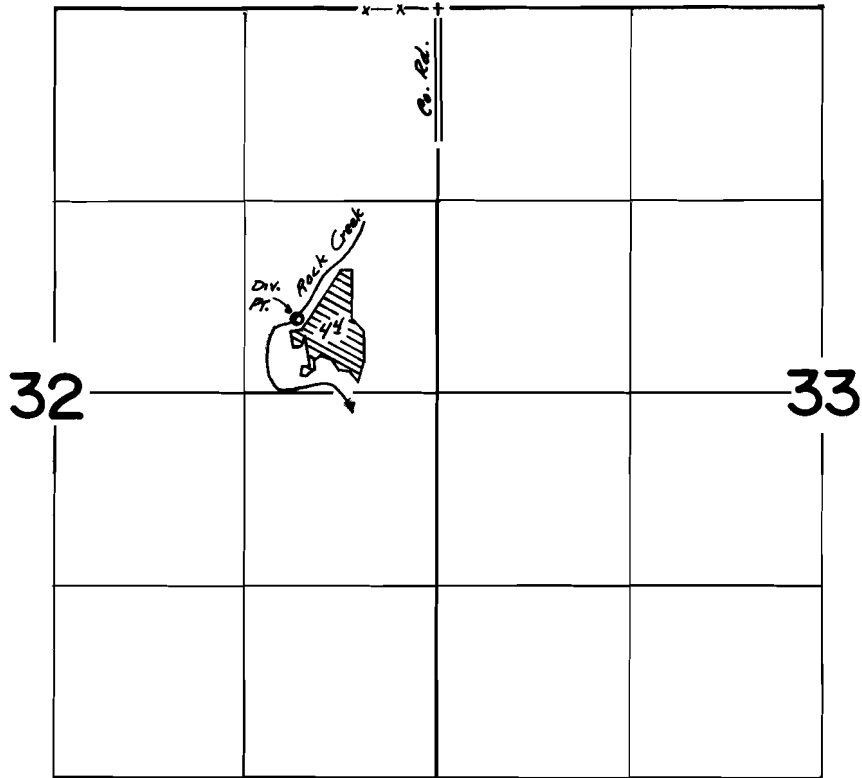

Div. Pt. Loc. - 2130'S ± 950'W From NE Cor. Sec. 32

**FINAL PROOF SURVEY**  
UNDER

Application No. 43893.. Permit No. 32809..  
IN NAME OF

...PERRYS SPORTS CAMP INC.....

Surveyed Aug. 10.. 1977., by S.C. BROWN.....