


T.7N.R.2W. W.M.

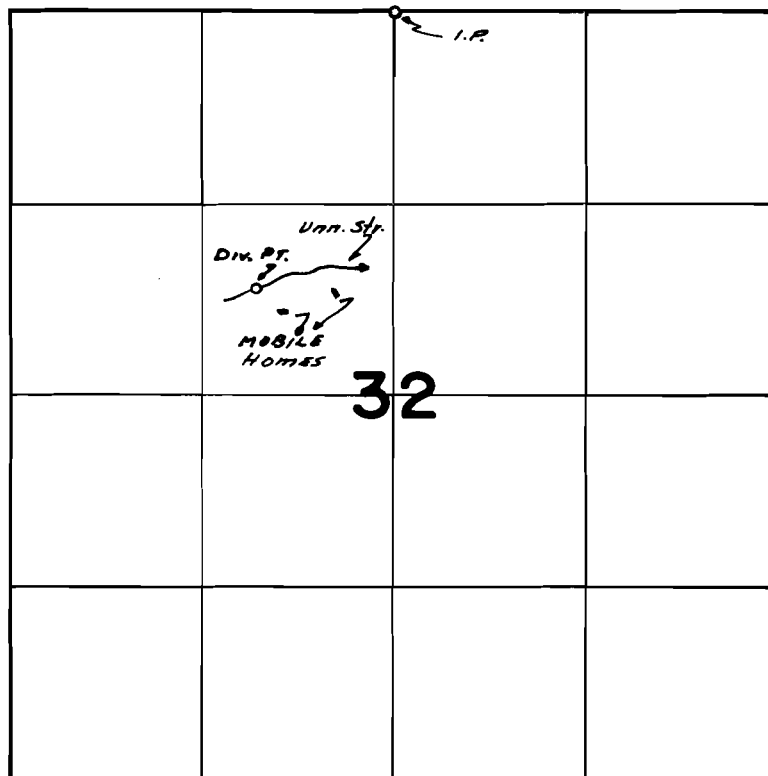

DIV. PT. LOC. 1900'S ± 950' W FROM N 1/4 COR. SEC. 32

FINAL PROOF SURVEY
UNDER

Application No. 46242... Permit No. 34549...
IN NAME OF

CLINTON, L... & ANN, J... HASH...

Surveyed Aug. 23, 1977, by S.C. BROWN...