


T.4N.R.4W. W.M.

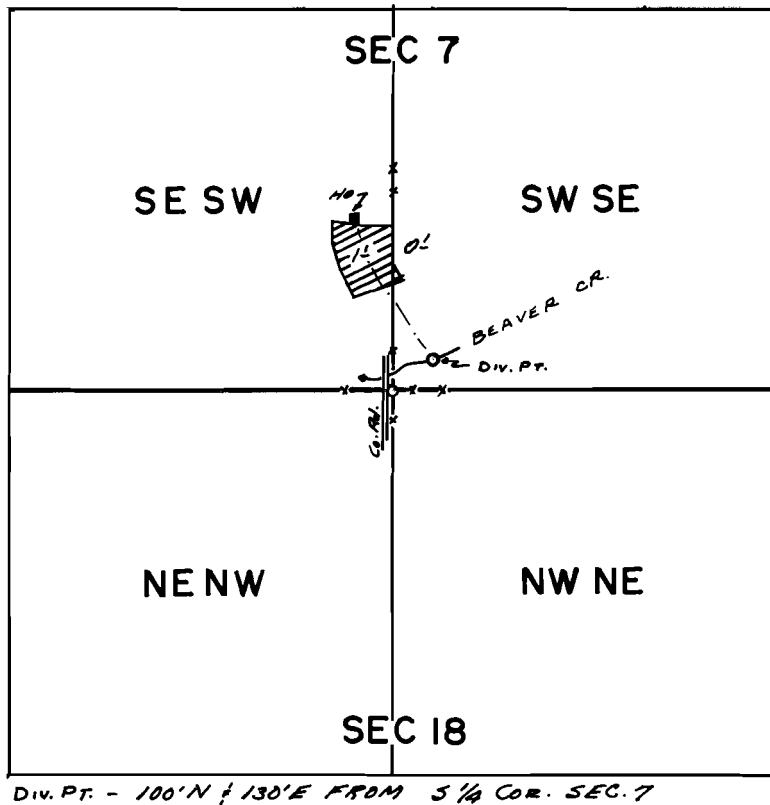

Scale 1" = 660'

FINAL PROOF SURVEY
UNDER

Application No. 53219... Permit No. 38069.
IN NAME OF

EVERETT K. MORGAN

Surveyed 8-10 1977, by S.C. BROWN