


T.39S. R.14W. W.M.

SCALE 1" = 500'

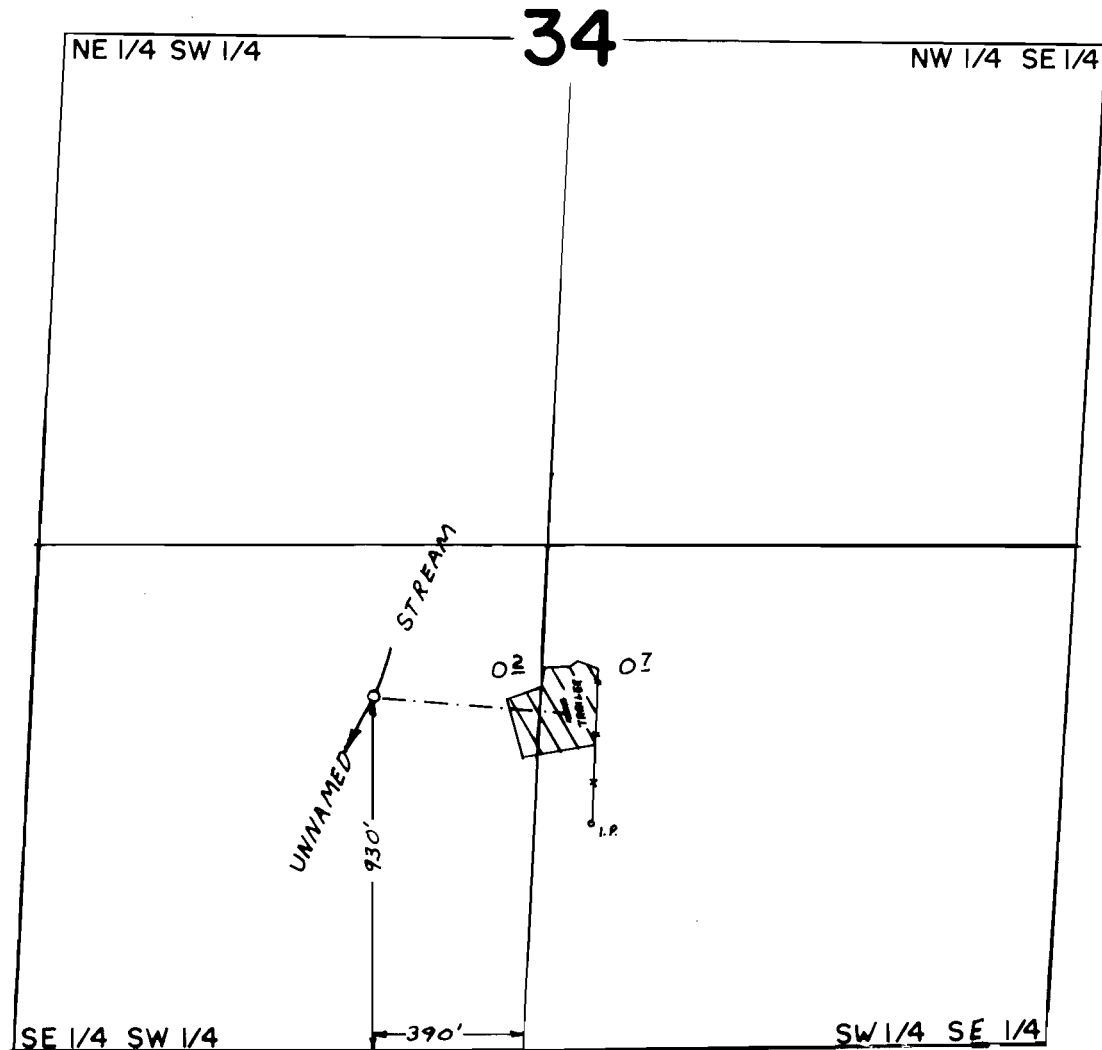

FINAL PROOF SURVEY
UNDER

Application No. 51256..... Permit No. 38711.....
IN NAME OF

.....MOYNE EUGENE BRALLIER.....

Surveyed SEP. 1..... 1976, by L.H. NUNN.....