


T. 33S. R. 6W. W.M.

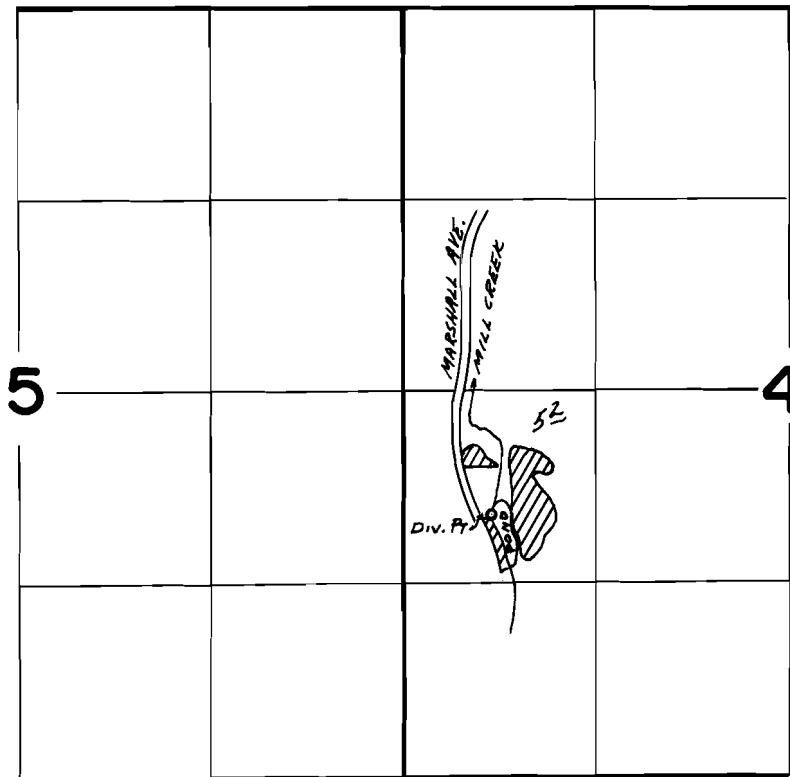

DN. Pt. Loc. - 1800' N & 600' E From SW Cor. Sec. 4

FINAL PROOF SURVEY UNDER

Application No. 501.37... Permit No. 37.910...
IN NAME OF

.....KENNETH & DOLLY RHODES.....

Surveyed April 27 1977., by D.M.NORBY.....