


T.32S. R.5W. W.M.

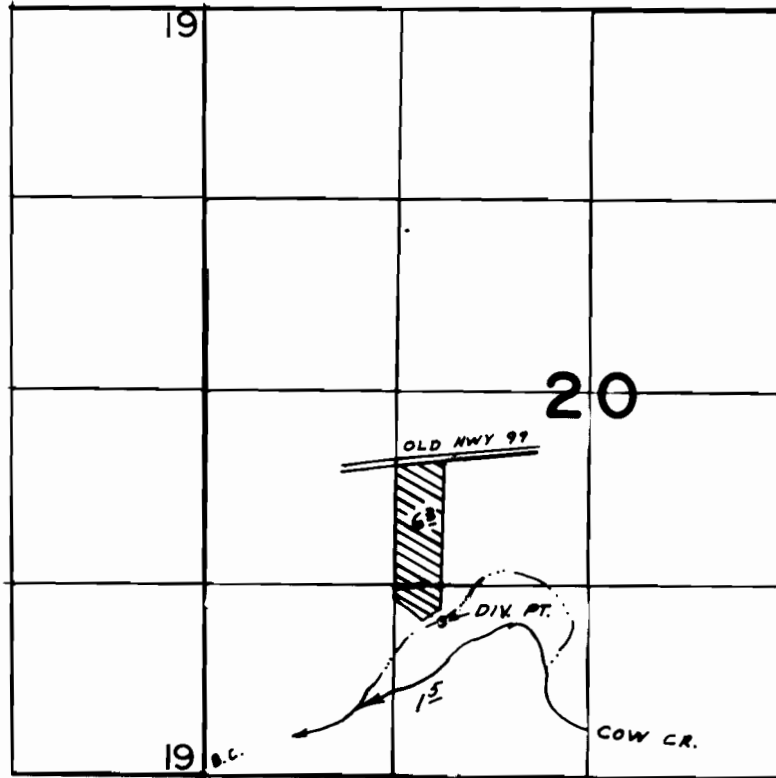

DIV. LOC: 1070' N. & 1620' E. FROM S.W. COR. SEC. 20

**FINAL PROOF SURVEY**  
UNDER

Application No. 50711 Permit No. 38301  
IN NAME OF

JAMES G. BOOTH

Surveyed JUL. 13. 1976, by L.H. NUNN