


P-40338

47399

47398

T.9S.R.31E.W.M.

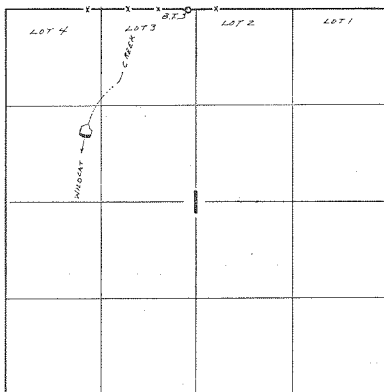

Div. Pt. Loc. 1700'S / 1550'W From N/4 Cor. Sec. 1

FINAL PROOF SURVEY
UNDER

R-53687 R-6431
Application No. 53688... Permit No. 40338...
IN NAME OF

.....STEPHEN L. BERSCH.....

Surveyed Oct. 14, 1977, by S.C. BROWN.....

PRS-1977-1 222