


P-40338

47344

47348

T.9S.R.31E.W.M.

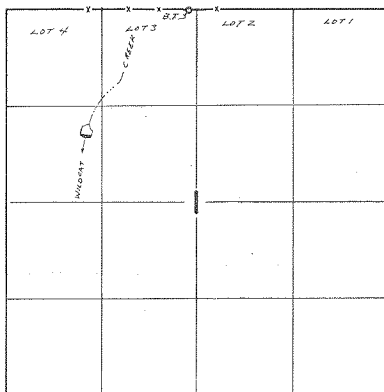

Dir. Pt. Loc. 1700'S of 1550'W From N¹/₄ Cor. Sec. 1

FINAL PROOF SURVEY UNDER

Application No. R-53687 R-6431
53688... Permit No. 40338...
IN NAME OF

.....STEPHEN L. BERSCH.....

Surveyed Oct. 14, 1977, by S.C. BROWN.....

PTS-1977-L-422