




T.10 S. R.27 E. W.M.

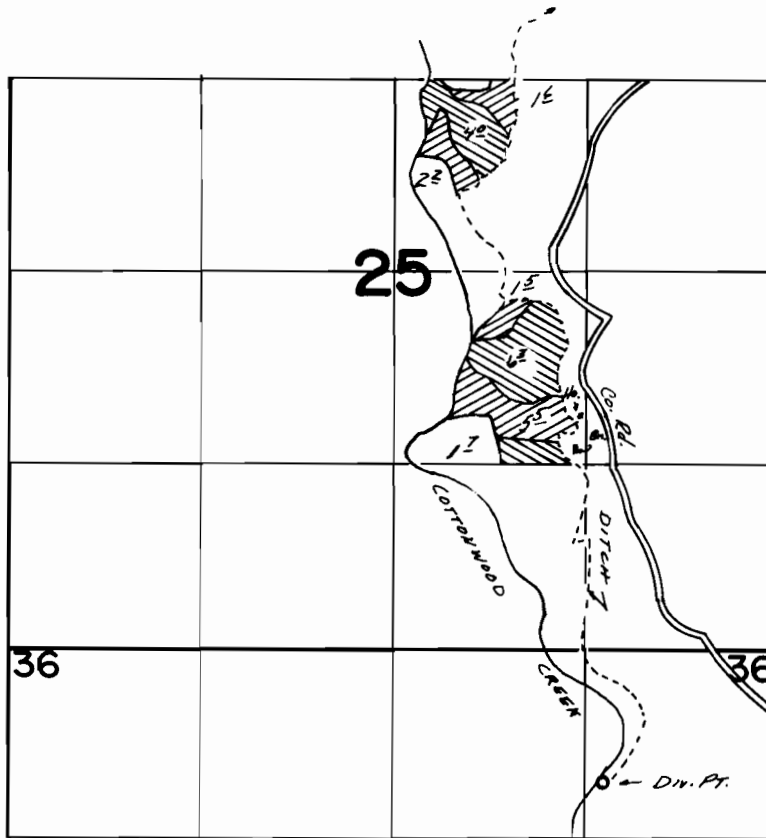

Div. Pt. Loc. 900' S of 1180' W From NE Cor. Sec. 36

PRIMARY 
SUPPL. TO
CERT. # 20306 

FINAL PROOF SURVEY UNDER

Application No. 54622 Permit No. 40984
IN NAME OF

BERNARD B. & GRACE G. FITZ

Surveyed Oct. 15, 1977, by S.C. BROWN