


T.24S., R.29E., W.M.

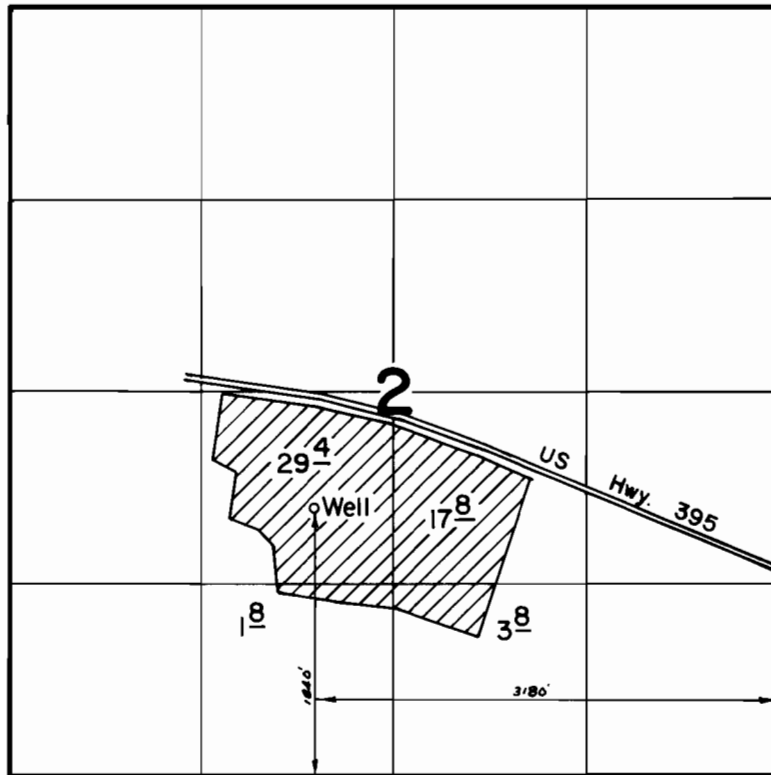

FINAL PROOF SURVEY UNDER

Application No. G-6529 Permit No. G-6139
IN NAME OF

.....D. STEPHEN McUNE.....

Surveyed April 21 1976, by D. Norby.....