


T. 36S. R. 1W. W.M.

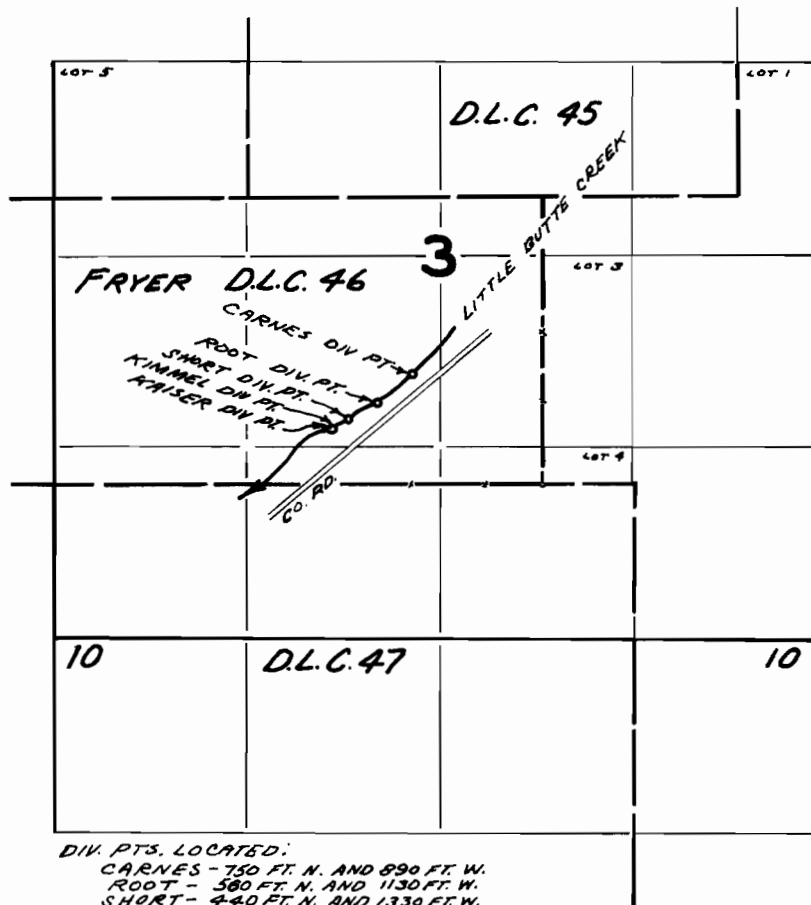

DIV. PTS. LOCATED:
CARNE'S - 750 FT. N. AND 890 FT. W.
ROOT - 580 FT. N. AND 1130 FT. W.
SHORT - 440 FT. N. AND 1330 FT. W.
KIMMEL - 380 FT. N. AND 1440 FT. W.
KAISER - 380 FT. N. AND 1450 FT. W.
ALL FROM SE COR. FRYER D.L.C. 46.

FINAL PROOF SURVEY
UNDER

TRANSFER No. K-44

Application No. _____ Permit No. _____

IN NAME OF

MICHAEL J. AND INITA R. KAISER ET AL.

Surveyed JUN. 5 1968, by V. GARNER