


T. 36 S. R. 1 W. W. M.

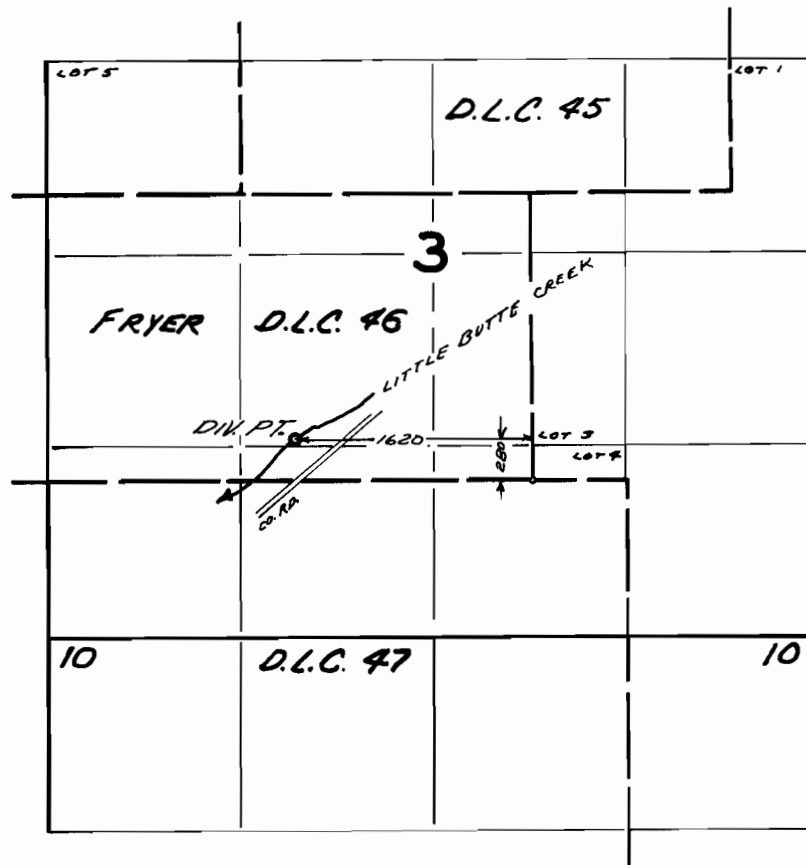


FINAL PROOF SURVEY
UNDER

TRANSFER M-166
Application No. Permit No.
IN NAME OF

JAMES L. AND MARIE D. MITCHELL

Surveyed JUN. 5, 1968, by V. GARNER

T.36S.R.IW.W.M.

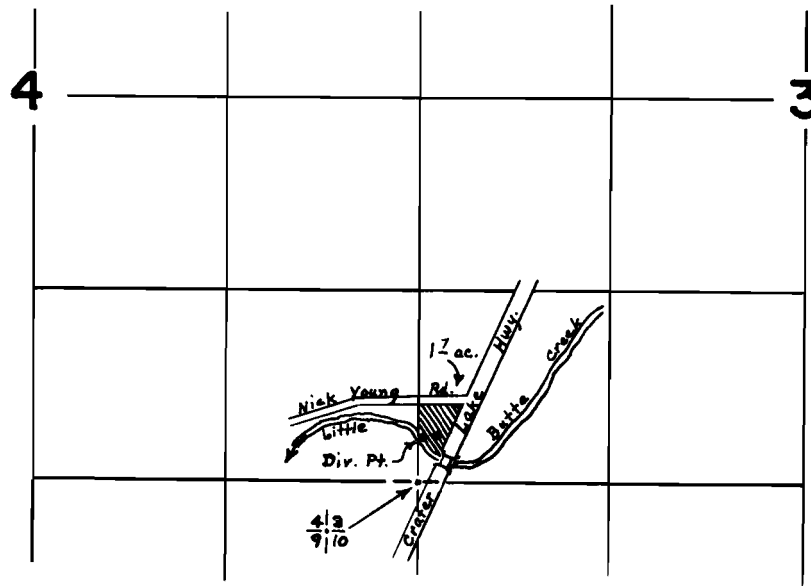

Diversion Point (Pump) is located 305' N. and
20' E. from S.W. Cor. Sec. 3.


FINAL PROOF SURVEY
UNDER

Transfer # D-119
Application No. _____ Permit No. _____
IN NAME OF

_____ Charles L. Leifheit _____

Surveyed Nov. 28, 1972, by D.C. Hendrix _____

T. 36 S., R. 1 W., W. M.

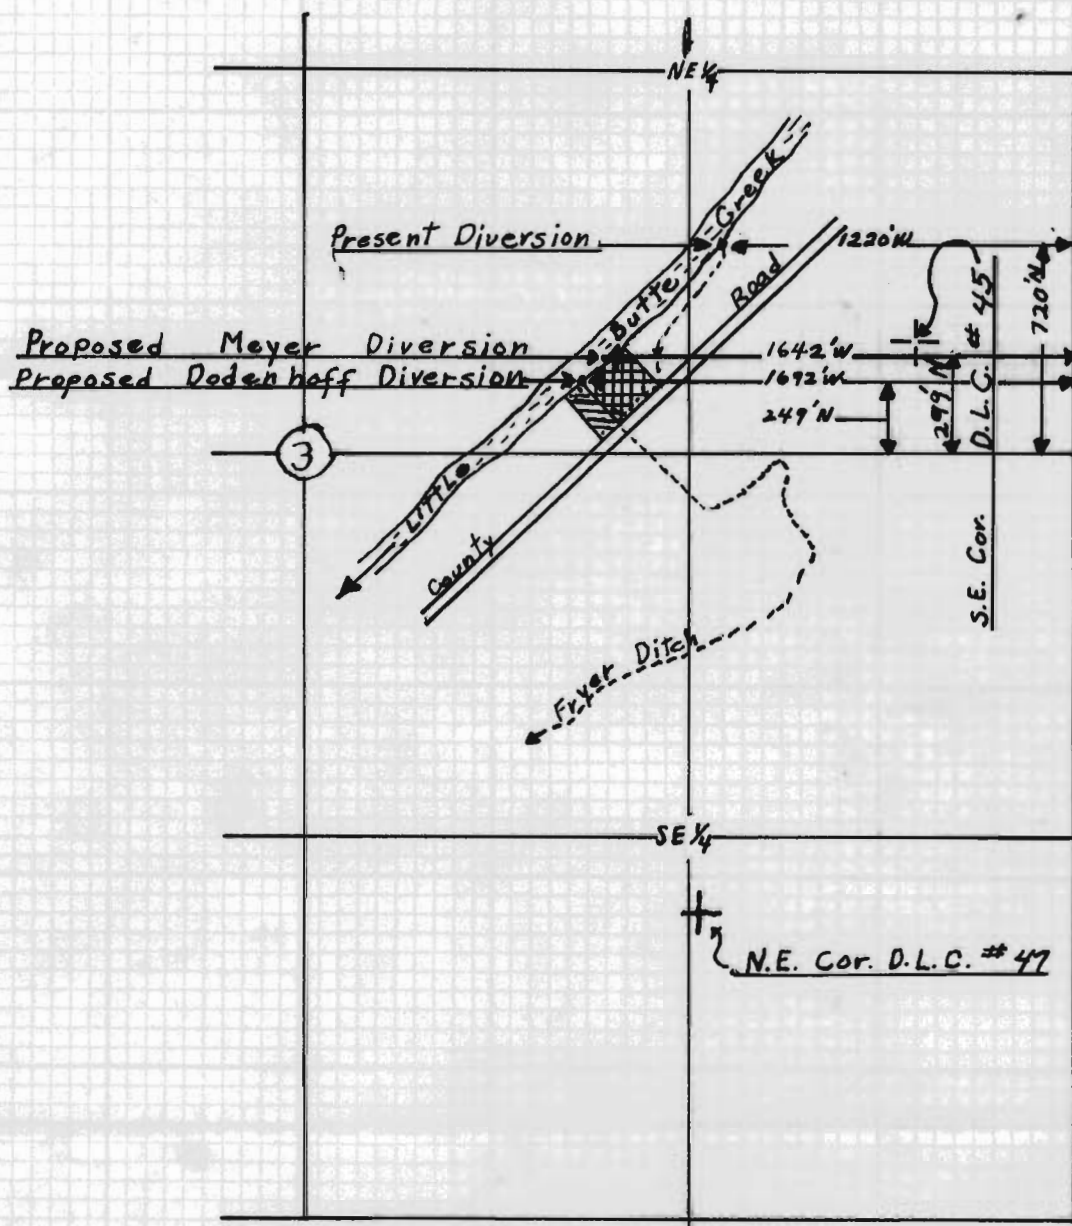

✓ see Vol. 9, P. 414
confirms this div. pt.

Larry A. Dodenhoff .2 acre represented by



Leland G. Meyer .6 acre represented by



Nov. 22, 1965

Scale: 8 inches = 1 mile

Map prepared by Leland G. Meyer

RECEIVED
NOV 26 1965
STATE ENGINEER
SALEM OREGON