


T.36S., R.1W., W.M.

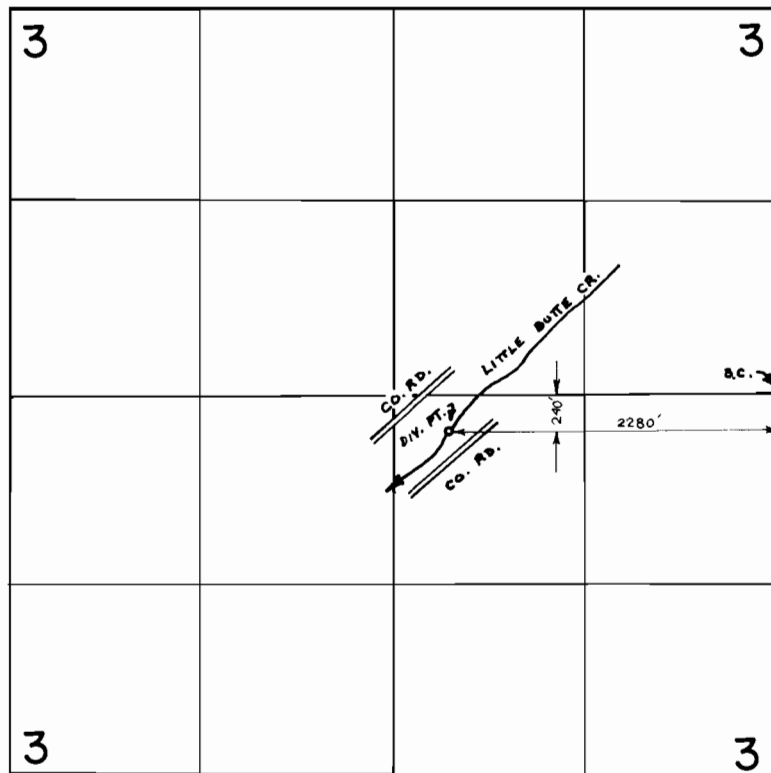

FINAL PROOF SURVEY
UNDER

Application No. T-2543 Permit No.
IN NAME OF

RALPH DANIEL

Surveyed AUG. 24 1978, by B. SUND