


T.36 S., R.1 W., W.M.

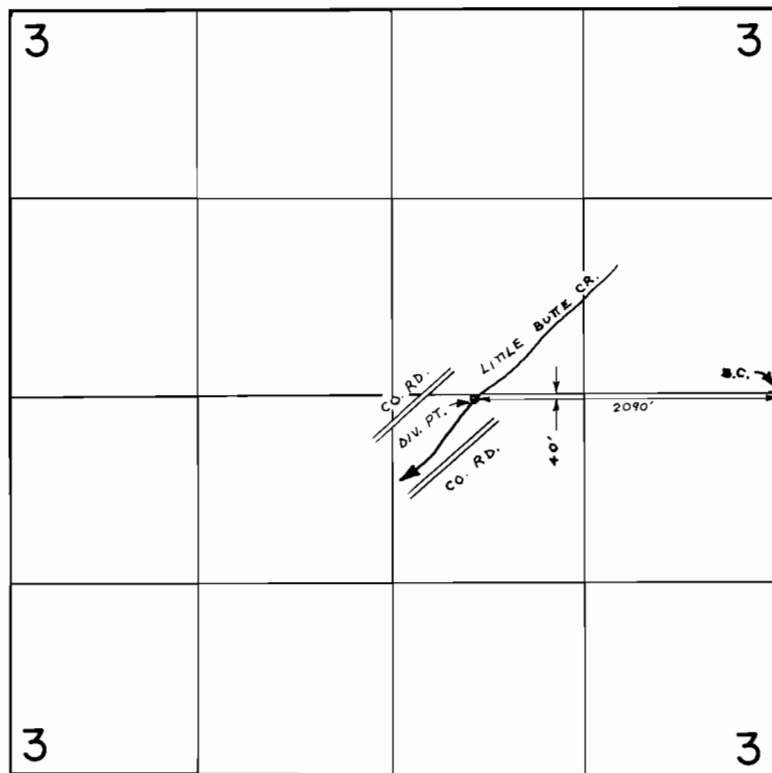

FINAL PROOF SURVEY
UNDER

Application No. T-2725 Permit No. _____
IN NAME OF

LEROY S. & MARY T. LOWMAN

Surveyed MAY 25 1978, by B. SUND