


T.34S.,R.6W.,W.M.

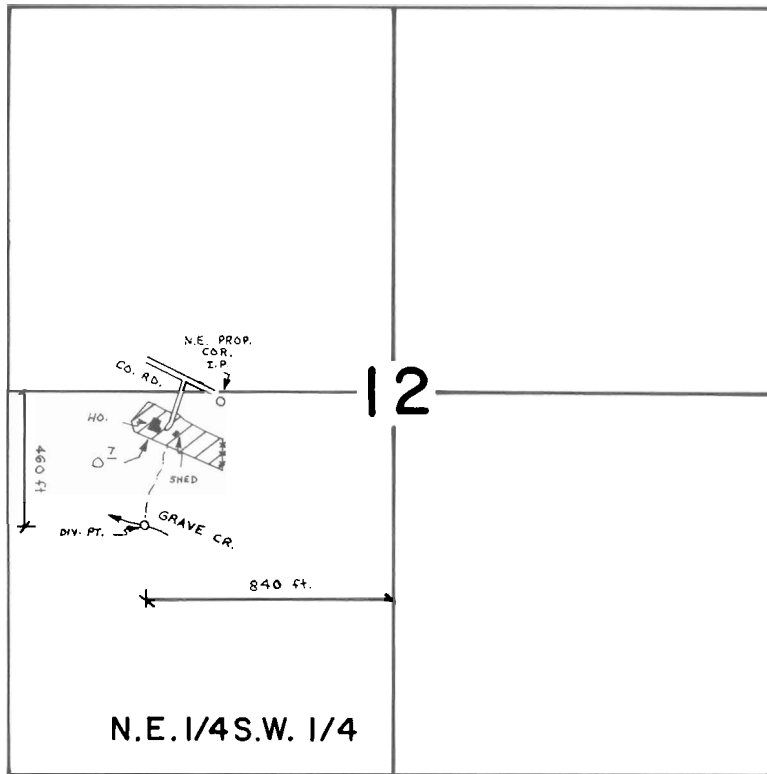

SCALE : 1" = 660 ft.

FINAL PROOF SURVEY
UNDER

Application No. 49531 Permit No. 37074
IN NAME OF

GERTRUDE E. PACE

Surveyed OCT. 27 1977, by B. SUND